

CORRECTION(S) TO WATER WELL RECORD (WWC-5)

(to rectify lacking or incorrect information)

County: Leavenworth

Location listed as:

Section-Township-Range: 35-52-22E

Fraction ($\frac{1}{4}$ $\frac{1}{4}$ $\frac{1}{4}$): NW NE NE

Location changed to:

35-85-22E

NW NE NE

Other changes: Initial statements: _____

Changed to: _____

Comments: _____

verification method: Well address, city street map, and mapping tool on KGS website.

initials: DRJ date: 12/20/2006

submitted by: Kansas Geological Survey, Data Resources Library, 1930 Constant Ave., Lawrence, KS 66047-3726
to: Kansas Dept of Health & Environment, Bureau of Water, 1000 SW Jackson, Suite 420, Topeka, KS 66612-1367.


1 LOCATION OF WATER WELL: County: Leavenworth Fraction: NW 1/4 NE 1/4 NE 1/4 Section Number: 35 Township Number: 52 Range Number: 22 E/W

Distance and direction from nearest town or city street address of well if located within city?

201 South Broadway, Leavenworth, KS

2 WATER WELL OWNER: Pelleman Oil
 RR#, St. Address, Box #: 201 S. Broadway
 City, State ZIP Code: Leavenworth

Global Positioning Systems (decimal degrees, min. of 4 digits)
 Latitude: unknown
 Longitude: unknown
 Elevation: 780.78'
 Datum: 781.53'
 Data Collection Method: unknown

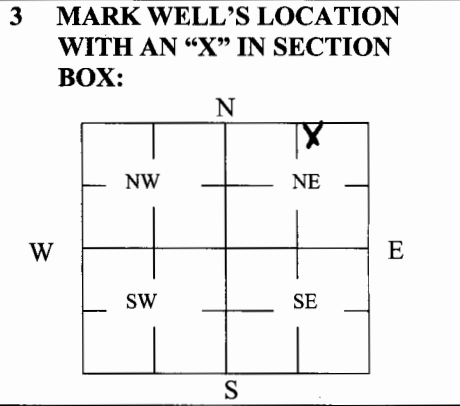

4 DEPTH OF WELL ~14 ft.
WELL'S STATIC WATER LEVEL 7.95 ft.

WELL WAS USED AS:

1 Domestic	5 Public Water Supply	9 Dewatering
2 Irrigation	6 Oil Field Water Supply	<input checked="" type="checkbox"/> 10 Monitoring
3 Feedlot	7 Domestic (Lawn & Garden)	11 Injection Well
4 Industrial	8 Air Conditioning	12 Other _____

Was a chemical/bacteriological sample submitted to Department? Yes _____ No

5 TYPE OF BLANK CASING USED:

1 Steel	3 RMP (SR)	5 Wrought	7 Fiberglass	9 Other (Specify below)
<input checked="" type="checkbox"/> 2 PVC	4 ABS	6 Asbestos-Cement	8 Concrete Tile	

Blank casing diameter 2 in. Was casing pulled? Yes _____ No _____ If yes, how much _____
 Casing height above or below land surface 0.75 feet

6 GROUT PLUG MATERIAL: 1 Neat cement 2 Cement grout 3 Bentonite 4 Other _____

Grout Plug Intervals: From 15 ft. to 0.5 ft., From _____ ft. to _____ ft., From _____ to _____ ft.

What is the nearest source of possible contamination:

1 Septic tank	6 Seepage pit	11 Fuel Storage	<input checked="" type="checkbox"/> 16 Other (specify below)
2 Sewer lines	7 Pit privy	12 Fertilizer storage	<u>former USTs</u>
3 Watertight sewer lines	8 Sewage lagoon	13 Insecticide storage	
4 Lateral lines	9 Feedyard	14 Abandoned water well	Direction from well? <u>West</u>
5 Cess pool	10 Livestock pens	15 Oil well/Gas well	How many feet? <u>30'</u>

FROM	TO	PLUGGING MATERIALS	FROM	TO	PLUGGING MATERIALS
<u>0.5</u>	<u>15</u>	<u>Hydrated Bentonite Chips</u>			

7 CONTRACTOR'S OR LANDOWNER'S CERTIFICATION: This water well was plugged under my jurisdiction and was completed on (mo/day/year) 11/10/06 and this record is true to the best of my knowledge and belief. Kansas Water Well Contractor's License No. 704. This Water Well Record was completed on (mo/day/year) 11/29/06 under the business name of maxs by (signature) David Humpal

INSTRUCTIONS: Use typewriter or ballpoint pen. Please press firmly and print clearly. Please fill in blanks, underline or circle the correct answers. Send top three copies to Kansas Department of Health and Environment, Bureau of Water, Geology Section, 1000 SW Jackson St., Ste. 420, Topeka, Kansas 66612-1367. Telephone: 785/296-5522. Send one to Water Well Owner and retain one for your records. Visit us at <http://www.kdheks.gov/geo/waterwells>.