


1 LOCATION OF WATER WELL: County: Leavenworth	Fraction SW 1/4 NW 1/4 SW 1/4	Section Number 26	Township Number 8S	Range Number 22E
--	---	-----------------------------	------------------------------	----------------------------

Distance and direction from nearest town or city street address of well if located within city?
 1323 W. Ottawa St. Leavenworth, KS

2 WATER WELL OWNER: Capital Electric Line Builders RR#, St. Address, Box #: 1428 W. 9 th St. City, State, ZIP Code: Kansas City, MO 64101-1220	Global Positioning System (decimal degrees, min. of 4 digits) Latitude: _____ Longitude: _____ Elevation: _____ Datum: _____ Data Collection Method: _____
--	---

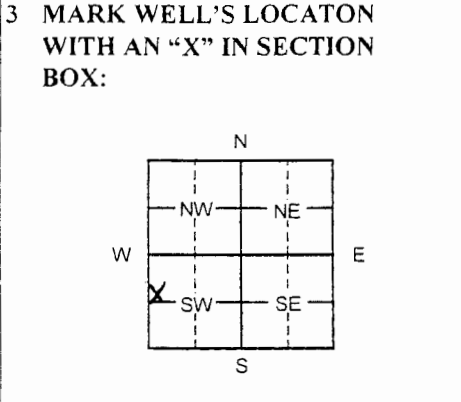

4 DEPTH OF WELL 13.50 ft. MW7

WELL'S STATIC WATER LEVEL _____ ft.

WELL WAS USED AS:

1 Domestic	5 Public Water Supply	9 Dewatering
2 Irrigation	6 Oil Field Water Supply	<input checked="" type="radio"/> 10 Monitoring
3 Feedlot	7 Domestic (Lawn & Garden)	11 Injection Well
4 Industrial	8 Air Conditioning	12 Other _____

Was a chemical/bacteriological sample submitted to Department? Yes ___ No X

5 TYPE OF BLANK CASING USED:

1 Steel	3 RMP (SR)	5 Wrought	7 Fiberglass	9 Other (specify below)
<input checked="" type="radio"/> 2 PVC	4 ABS	6 Asbestos-Cement	8 Concrete Tile	_____

Blank casing diameter 2 in. Was casing pulled? Yes X No ___ If yes, how much 4.0ft.
 Casing height above or below land surface _____ in.

6 GROUT PLUG MATERIAL: 1 Neat cement 2 Cement grout 3 Bentonite 4 Other Soil 0-3ft

Grout Plug Intervals: From 3 ft. to 13.50 ft.

What is the nearest source of possible contamination:

1 Septic tank	6 Seepage pit	11 Fuel storage	16 Other (specify below)
2 Sewer lines	7 Pit privy	12 Fertilizer storage	_____
3 Watertight sewer lines	8 Sewage lagoon	13 Insecticide storage	_____
4 Lateral lines	9 Feedyard	14 Abandoned water well	Direction from well?
5 Cess pool	10 Livestock pens	15 Oil well/Gas well	How many feet?

FROM	TO	PLUGGING MATERIALS	FROM	TO	PLUGGING MATERIALS
0	3	Soil			
3	13.50	Bentonite			

7 CONTRACTOR'S OR LANDOWNER'S CERTIFICATION: This water well was plugged under my jurisdiction and was completed on (mo/day/year) 12/3/09 and this record is true to the best of my knowledge and belief. Kansas Water Well Contractor's License No. 757. This Water Well Record was completed on (mo/day/year) 12/29/09 under the business name of Larsen and Associates, Inc. by (signature) _____

INSTRUCTIONS: Please fill in blanks or circle the correct answers. Send top three copies to Kansas Department of Health and Environment, Bureau of Water, Geology Section, 1000 SW Jackson St., Ste. 420, Topeka, Kansas 66612-1367. Telephone: 785/296-3522. Send one to Water Well Owner and retain one for your records. Visit us at <http://www.kdheks.gov/waterwell>.

Well Abandonment Form

Site: Capital Electric Line Builders, Inc.

City: 1320 Ottawa Street, Leavenworth, KS

Date: 5/27/04

Field Staff: *ML*

Well # (MW)	Well Total Depth	Total Casing Footage Pulled	Surface Cover Interval	Surface Cover Type (soil/ concrete/ asphalt)	Interval Plugged with Soil	Interval Plugged with Bentonite	Time	KDHE Well Lock (old)	KDHE Well Tag	NOTES
MW1	20	20	0-3'0"	S/C/A	3-3'0"	30-20'05	0930	0267489 <i>ML</i>	00359894 <i>ML</i>	3598
MW2	19.55	20	0-3'0"	S/C/A	0-3'0"	30-19.55	1030 1030	0267106 <i>ML</i>	00359887 <i>ML</i>	
MW4	18.50	20	8'	S/C/A	8-3'0"	30-18.30	0952	0267528 <i>ML</i>	00359863 <i>ML</i>	Unable to find KDHE Tag.
MW5	17.75	20	0-3'0"	S/C/A	0-3'0"	30-17.75	1000	0267535 <i>ML</i>	00359832 <i>ML</i>	
MW6	17.0	20	0-3'0"	S/C/A	0-3'0"	30-17.0	1145	0267426 <i>ML</i>	00359849 <i>ML</i>	
MW7	16.50	20	0-3'0"	S/C/A	0-3'0"	30-16.50	1020	0267499 <i>ML</i>	00359856 <i>ML</i>	

Observations:

Well to use with labels & measurements for MW 2 used with labels.
 Double to get all three ft of pipe for MW's. ~~both~~ *pull* pipe of at 2 ft
 double together. *labeled* bag (out of office). *Talked w/ Stephanie she*
*has a plan of MW 7 Tools used. *Foot Hammer, generator, saw bar, shovels**
12 lbs soil 5 lbs bentonite plug.

Field Staff Signature: *ML*