

**CORRECTION(S) TO WATER WELL RECORD (WWC-5)**  
(to rectify lacking or incorrect information)

County: Leavenworth

**Location listed as:**

Section-Township-Range: 22-8-22 E

Fraction ( 1/4 1/4 1/4): \_\_\_\_\_

**Location changed to:**

12-85-22 E

NW NE NW

**Other changes:** Initial statements: \_\_\_\_\_

Changed to: \_\_\_\_\_

Comments: \_\_\_\_\_


verification method: Well location given for construction record,  
and mapping tool on KGS website.

initials: GRJ date: 7/12/2011

submitted by: Kansas Geological Survey, Data Resources Library, 1930 Constant Ave., Lawrence, KS 66047-3726  
to: Kansas Dept of Health & Environment, Bureau of Water, 1000 SW Jackson, Suite 420, Topeka, KS 66612-1367.

**1 LOCATION OF WATER WELL:** Fraction  $\frac{1}{4}$   $\frac{1}{4}$   $\frac{1}{4}$  Section Number 22 Township Number 8 Range Number 22 **EN**  
 County: Leavenworth  
 Distance and direction from nearest town or city street address of well if located within city?

**2 WATER WELL OWNER:** US Army CMC  
 RR#, St. Address, Box #: 841 McClellan Ave.  
 City, State ZIP Code: Fort Leavenworth, KS. 66027  
**Global Positioning Systems** (decimal degrees, min. of 4 digits)  
 Latitude: \_\_\_\_\_  
 Longitude: \_\_\_\_\_  
 Elevation: \_\_\_\_\_  
 Datum: \_\_\_\_\_  
 Data Collection Method: \_\_\_\_\_

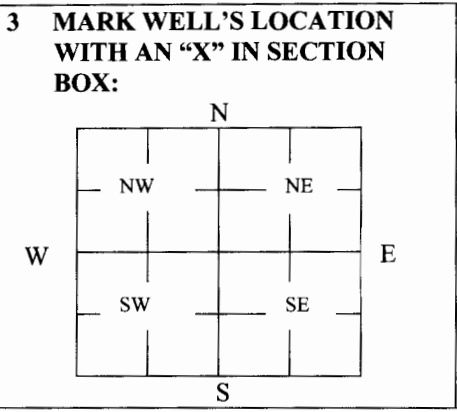

**4 DEPTH OF WELL** 49.7 ft.  
 WELL'S STATIC WATER LEVEL 14.9 ft.  
 WELL WAS USED AS:  
 1 Domestic                      5 Public Water Supply                      9 Dewatering  
 2 Irrigation                      6 Oil Field Water Supply                      10 **Monitoring**  
 3 Feedlot                          7 Domestic (Lawn & Garden)                      11 Injection Well  
 4 Industrial                      8 Air Conditioning                          12 Other \_\_\_\_\_  
 Was a chemical/bacteriological sample submitted to Department? Yes \_\_\_\_\_ No X

**5 TYPE OF BLANK CASING USED:**  
 1 Steel      3 RMP (SR)      5 Wrought      7 Fiberglass      9 Other (Specify below)  
 2 **PVC**      4 ABS      6 Asbestos-Cement      8 Concrete Tile  
 Blank casing diameter 2 in. Was casing pulled? Yes X No \_\_\_\_\_ If yes, how much 49'  
 Casing height above or below land surface \_\_\_\_\_ in.

**6 GROUT PLUG MATERIAL:** 1 Neat cement      2 Cement grout      3 **Bentonite**      4 Other \_\_\_\_\_  
 Grout Plug Intervals: From 0 ft. to 49.7 ft., From \_\_\_\_\_ ft. to \_\_\_\_\_ ft., From \_\_\_\_\_ to \_\_\_\_\_ ft.  
 What is the nearest source of possible contamination:  
 1 Septic tank      6 Seepage pit      11 Fuel Storage      16 Other (specify below)  
 2 Sewer lines      7 Pit privy      12 Fertilizer storage  
 3 Watertight sewer lines      8 Sewage lagoon      13 Insecticide storage  
 4 Lateral lines      9 Feedyard      14 Abandoned water well      Direction from well? \_\_\_\_\_  
 5 Cess pool      10 Livestock pens      15 Oil well/Gas well      How many feet? \_\_\_\_\_

| FROM     | TO           | PLUGGING MATERIALS | FROM | TO | PLUGGING MATERIALS |
|----------|--------------|--------------------|------|----|--------------------|
| <u>0</u> | <u>49.7'</u> | <u>Bentonite</u>   |      |    |                    |
|          |              |                    |      |    |                    |
|          |              |                    |      |    |                    |
|          |              |                    |      |    |                    |
|          |              |                    |      |    |                    |

**7 CONTRACTOR'S OR LANDOWNER'S CERTIFICATION:** This water well was plugged under my jurisdiction and was completed on (mo/day/year) 6-2-11 and this record is true to the best of my knowledge and belief. Kansas Water Well Contractor's License No. 604. This Water Well Record was completed on (mo/day/year) 6/6/11 under the business name of Environmental Priority Service, Inc. by (signature) P. H. A. M. T.

**INSTRUCTIONS:** Use typewriter or ballpoint pen. Please press firmly and print clearly. Please fill in blanks, underline or circle the correct answers. Send top three copies to Kansas Department of Health and Environment, Bureau of Water, Geology Section, 1000 SW Jackson St., Ste. 420, Topeka, Kansas 66612-1367. Telephone: 785/296-5522. Send one to Water Well Owner and retain one for your records. Visit us at <http://www.kdheks.gov/geo/waterwells>.