

CORRECTION(S) TO WATER WELL RECORD (WWC-5)
(to rectify lacking or incorrect information)

County: Leavenworth

Location listed as:

Location changed to:

Section-Township-Range: 9-245-4E

22-85-22E

Fraction (1/4 1/4 1/4): NW

NW NW NE NE

Other changes: Initial statements: _____

Changed to: _____

Comments: _____

verification method: Latitude & Longitude, KGS' "LEO" conversion tool, and mapping tool on KGS website.

initials: DRB date: 5/25/2012


submitted by: Kansas Geological Survey, Data Resources Library, 1930 Constant Ave., Lawrence, KS 66047-3726
to: Kansas Dept of Health & Environment, Bureau of Water, 1000 SW Jackson, Suite 420, Topeka, KS 66612-1367.

MW-1
WATER WELL PLUGGING RECORD Form WWC-5P KSA 82a-1212 ID NO.

1 LOCATION OF WATER WELL: Fraction $\frac{1}{4}$ $\frac{1}{4}$ NW $\frac{1}{4}$ Section Number 9 Township Number 24 S Range Number 4 W
 County: Leavenworth

Distance and direction from nearest town or city street address of well if located within city?
150' SE. of Iowa Ave. + 5th Artillery

2 WATER WELL OWNER: US Army Corps of Engineers Global Positioning Systems (decimal degrees, min. of 4 digits)
 RR#, St. Address, Box #: 809 Harrison Drive, bldg 80 Latitude: 39.34602137
 City, State ZIP Code: Ft. Leavenworth, KS. 66027 Longitude: -94.940398
 Elevation: _____ Datum: _____
 Data Collection Method: _____

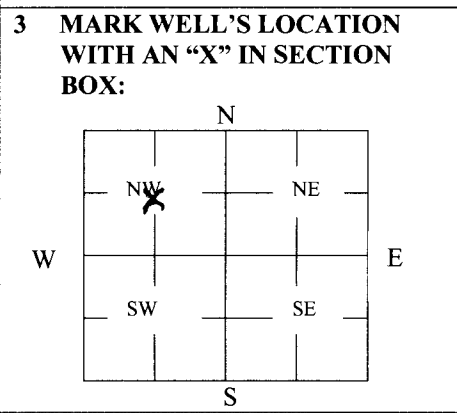

4 DEPTH OF WELL 46.36 ft.
 WELL'S STATIC WATER LEVEL 17 ft.
 WELL WAS USED AS:
 1 Domestic 5 Public Water Supply 9 Dewatering
 2 Irrigation 6 Oil Field Water Supply 10 Monitoring
 3 Feedlot 7 Domestic (Lawn & Garden) 11 Injection Well
 4 Industrial 8 Air Conditioning 12 Other _____
 Was a chemical/bacteriological sample submitted to Department? Yes _____ No

5 TYPE OF BLANK CASING USED:
 1 Steel 3 RMP (SR) 5 Wrought 7 Fiberglass 9 Other (Specify below)
 2 PVC 4 ABS 6 Asbestos-Cement 8 Concrete Tile
 Blank casing diameter 2 in. Was casing pulled? Yes No _____ If yes, how much 46.36 ft.
 Casing height above or below land surface 36 in.

6 GROUT PLUG MATERIAL: 1 Neat cement 2 Cement grout 3 Bentonite 4 Other _____
 Grout Plug Intervals: From 0 ft. to 46.36 ft., From _____ ft. to _____ ft., From _____ to _____ ft.

What is the nearest source of possible contamination:
 1 Septic tank 6 Seepage pit 11 Fuel Storage 16 Other (specify below)
 2 Sewer lines 7 Pit privy 12 Fertilizer storage
 3 Watertight sewer lines 8 Sewage lagoon 13 Insecticide storage
 4 Lateral lines 9 Feedyard 14 Abandoned water well Direction from well? _____
 5 Cess pool 10 Livestock pens 15 Oil well/Gas well How many feet? _____

FROM	TO	PLUGGING MATERIALS	FROM	TO	PLUGGING MATERIALS
<u>0</u>	<u>46.36</u>	<u>Bentonite Grout</u>			

7 CONTRACTOR'S OR LANDOWNER'S CERTIFICATION: This water well was plugged under my jurisdiction and was completed on (mo/day/year) 4-2-12 and this record is true to the best of my knowledge and belief. Kansas Water Well Contractor's License No. 604. This Water Well Record was completed on (mo/day/year) 5/1/12 under the business name of Environmental Priority Service, Inc. by (signature) Pat MTE

INSTRUCTIONS: Use typewriter or ballpoint pen. Please press firmly and print clearly. Please fill in blanks, underline or circle the correct answers. Send top three copies to Kansas Department of Health and Environment, Bureau of Water, Geology Section, 1000 SW Jackson St., Ste. 420, Topeka, Kansas 66612-1367. Telephone: 785/296-5522. Send one to Water Well Owner and retain one for your records. Visit us at <http://www.kdheks.gov/geo/waterwells>.