

County: Leavenworth Fraction NW NW NE NW Sec. 26 T 8 S R 22 EW

CORRECTION(S) TO WATER WELL COMPLETION RECORD (WWC-5)

(to rectify lacking or incorrect information)

Owner: U. S. Federal Bureau of Prisons

Location was listed as:

Section-Township-Range: 22-52N-22E

Fraction ($\frac{1}{4}$ $\frac{1}{4}$ $\frac{1}{4}$): SE SE SE

Location changed to:

26-8S-22E

NW NW NE NW

Other changes: Initial statements: _____

Changed to: _____

Comments: _____

Verification method: Latitude & Longitude, KGS' "LEO" conversion tool,
and mapping tool on KGS website.

initials: DPA date: 8/29/2014

Submitted by: Kansas Geological Survey, Data Resources Library, 1930 Constant Ave., Lawrence, KS 66047-3726

to: Kansas Dept of Health & Environment, Bureau of Water, 1000 SW Jackson, Suite 420, Topeka, KS 66612-1367.

MW11

WATER WELL PLUGGING RECORD Form WWC-5P

KSA 82a-1212

ID NO.

1 LOCATION OF WATER WELL: County: <u>Leavenworth</u>	Fraction <u>SE 1/4 SE 1/4 SE 1/4</u>	Section Number <u>22</u>	Township Number <u>52N</u>	Range Number <u>22</u> <u>EW</u>
---	---	-----------------------------	-------------------------------	-------------------------------------

Distance and direction from nearest town or city street address of well if located within city?

1300 Metropolitan Ave. Leavenworth, KS2 WATER WELL OWNER: **U.S. Federal Bureau of Prisons**

RR#, St. Address, Box #:

City, State ZIP Code:

Global Positioning Systems (decimal degrees, min. of 4 digits)

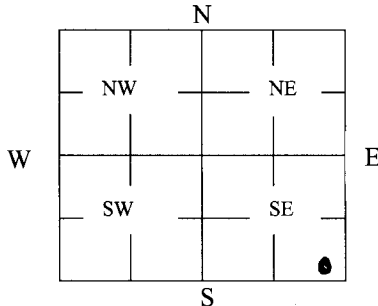
Latitude: 39 19 55.16Longitude: 094 55 53.89

Elevation: _____

Datum: _____

Data Collection Method: Google Earth

3 MARK WELL'S LOCATION WITH AN "X" IN SECTION BOX:

4 DEPTH OF WELL 27' ft.WELL'S STATIC WATER LEVEL 10.02 ft

WELL WAS USED AS:

- 1 Domestic
- 2 Irrigation
- 3 Feedlot
- 4 Industrial

- 5 Public Water Supply
- 6 Oil Field Water Supply
- 7 Domestic (Lawn & Garden)
- 8 Air Conditioning

- 9 Dewatering
- ☒ 10 Monitoring
- 11 Injection Well
- 12 Other _____

Was a chemical/bacteriological sample submitted to Department? Yes _____ No ☒ X

5 TYPE OF BLANK CASING USED:

- 1 Steel
- 2 PVC
- 3 RMP (SR)
- 4 ABS
- 5 Wrought
- 6 Asbestos-Cement
- 7 Fiberglass
- 8 Concrete Tile

☒ 9 Other (Specify below)~~Stainless Steel~~ 304

Blank casing diameter 2" in. Was casing pulled? Yes ☒ No _____ If yes, how much All 27'

Casing height above or below land surface 3' in.

6 GROUT PLUG MATERIAL: 1 Neat cement 2 Cement grout ☒ 3 Bentonite ☒ 4 Other ClayGrout Plug Intervals: From 27' ft. to 1' ft., From 1' ft. to 0' ft., From _____ to _____ ft.

What is the nearest source of possible contamination:

- 1 Septic tank
- 2 Sewer lines
- 3 Watertight sewer lines
- 4 Lateral lines
- 5 Cess pool
- 6 Seepage pit
- 7 Pit privy
- 8 Sewage lagoon
- 9 Feedyard
- 10 Livestock pens
- 11 Fuel Storage
- 12 Fertilizer storage
- 13 Insecticide storage
- 14 Abandoned water well
- 15 Oil well/Gas well

☒ 16 Other (specify below)Possible Landfill

Direction from well? _____

How many feet? _____

FROM	TO	PLUGGING MATERIALS	FROM	TO	PLUGGING MATERIALS
		Bentonite from <u>27'-1'</u>			
		Soil from <u>1'-0'</u>			

7 CONTRACTOR'S OR LANDOWNER'S CERTIFICATION: This water well was plugged under my jurisdiction and was completed on (mo/day/year) 7/22/14 and this record is true to the best of my knowledge and belief. Kansas Water Well Contractor's License No. 732. This Water Well Record was completed on (mo/day/year) 7/26/14 under the business name of JB Environmental Drilling by (signature) James Bueker

INSTRUCTIONS: Use typewriter or ballpoint pen. Please press firmly and print clearly. Please fill in blanks, underline or circle the correct answers. Send top three copies to Kansas Department of Health and Environment, Bureau of Water, Geology Section, 1000 SW Jackson St., Ste. 420, Topeka, Kansas 66612-1367. Telephone: 785/296-5522. Send one to Water Well Owner and retain one for your records. Visit us at <http://www.kdheks.gov/geo/waterwells>.