

County: Leavenworth Fraction SW NW NE NW Sec. 26 T 8 S R 22 EW

CORRECTION(S) TO WATER WELL COMPLETION RECORD (WWC-5)

(to rectify lacking or incorrect information)

Owner: U. S. Federal Bureau of Prisons

Location was listed as:

Location changed to:

Section-Township-Range: 22-52N-22E

26-8S-22E

Fraction ($\frac{1}{4}$ $\frac{1}{4}$ $\frac{1}{4}$): SE SE SE

SW NW NE NW

Other changes: Initial statements: _____

Changed to: _____

Comments: _____

Verification method: Latitude & Longitude, KGS' "LEO" conversion tool,
and mapping tool on KGS website.

initials: ORA date: 8/29/2014

Submitted by: Kansas Geological Survey, Data Resources Library, 1930 Constant Ave., Lawrence, KS 66047-3726
to: Kansas Dept of Health & Environment, Bureau of Water, 1000 SW Jackson, Suite 420, Topeka, KS 66612-1367.

MW12A

WATER WELL PLUGGING RECORD Form WWC-5P KSA 82a-1212 ID NO.

1 LOCATION OF WATER WELL: Fraction SE 1/4 SE 1/4 SE 1/4 Section Number 22 Township Number 52N Range Number 22 EW
 County: Leavenworth

Distance and direction from nearest town or city street address of well if located within city?

1300 Metropolitan Ave. Leavenworth, KS

2 WATER WELL OWNER: U.S. Federal Bureau of Prisons

RR#, St. Address, Box #:

City, State ZIP Code:

Global Positioning Systems (decimal degrees, min. of 4 digits)


Latitude: 39 19 50.41Longitude: 094 55 52.17

Elevation:

Datum:

Data Collection Method: Google Earth

3 MARK WELL'S LOCATION WITH AN "X" IN SECTION BOX:

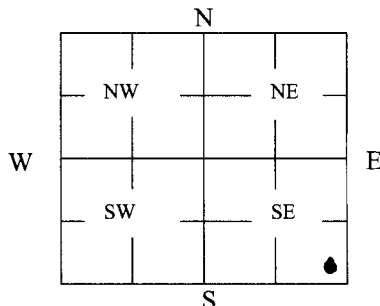

4 DEPTH OF WELL 15' ft.

WELL'S STATIC WATER LEVEL 4.05 ft

WELL WAS USED AS:

1 Domestic

2 Irrigation

3 Feedlot

4 Industrial

5 Public Water Supply

6 Oil Field Water Supply

7 Domestic (Lawn & Garden)

8 Air Conditioning

9 Dewatering

☒ 10 Monitoring

11 Injection Well

12 Other _____

Was a chemical/bacteriological sample submitted to Department? Yes _____ No ☒

5 TYPE OF BLANK CASING USED:

1 Steel

3 RMP (SR)

5 Wrought

7 Fiberglass

☒ Other (Specify below)

2 PVC

4 ABS

6 Asbestos-Cement

8 Concrete Tile

~~Stainless Steel~~ 304Blank casing diameter 2" in.Was casing pulled? Yes ☒ No _____If yes, how much All 10'Casing height above or below land surface 2' in.

6 GROUT PLUG MATERIAL:

1 Neat cement

2 Cement grout

☒ 3 Bentonite☒ 4 Other clayGrout Plug Intervals: From 10' ft. to 1' ft., From 1' ft. to 0' ft., From _____ to _____ ft.

What is the nearest source of possible contamination:

1 Septic tank

6 Seepage pit

11 Fuel Storage

☒ 16 Other (specify below)

2 Sewer lines

7 Pit privy

12 Fertilizer storage

Possible Landfill

3 Watertight sewer lines

8 Sewage lagoon

13 Insecticide storage

4 Lateral lines

9 Feedyard

14 Abandoned water well

Direction from well? _____

5 Cess pool

10 Livestock pens

15 Oil well/Gas well

How many feet? _____

| FROM | TO | PLUGGING MATERIALS | FROM | TO | PLUGGING MATERIALS |
|------|----|------------------------------|------|----|--------------------|
| | | | | | |
| | | <u>Bentonite from 10'-1'</u> | | | |
| | | <u>Soil from 1'-0'</u> | | | |
| | | | | | |
| | | | | | |
| | | | | | |
| | | | | | |

7 CONTRACTOR'S OR LANDOWNER'S CERTIFICATION: This water well was plugged under my jurisdiction and was completed on (mo/day/year) 7/22/14 and this record is true to the best of my knowledge and belief. Kansas Water Well Contractor's License No. 732. This Water Well Record was completed on (mo/day/year) 7/26/14 under the business name of JB Environmental Drilling by (signature) James Bueker

INSTRUCTIONS: Use typewriter or ballpoint pen. Please press firmly and print clearly. Please fill in blanks, underline or circle the correct answers. Send top three copies to Kansas Department of Health and Environment, Bureau of Water, Geology Section, 1000 SW Jackson St., Ste. 420, Topeka, Kansas 66612-1367. Telephone: 785/296-5522. Send one to Water Well Owner and retain one for your records. Visit us at <http://www.kdheks.gov/geo/waterwells>.