


1 LOCATION OF WATER WELL: Fraction SE 1/4 SW 1/4 NE 1/4 Section Number 35 Township Number T 8 S Range Number R 22 EW  
 County: Leavenworth  
 Distance and direction from nearest town or city street address of well if located within city?  
788 Spruce, Leavenworth, Ks.

2 WATER WELL OWNER: Wood's Mini Mart  
 RR#, St. Address, Box #: 788 Spruce P.O. Box 67 Board of Agriculture, Division of Water Resources  
 City, State, ZIP Code: Leavenworth, Ks. 66048 Application Number:

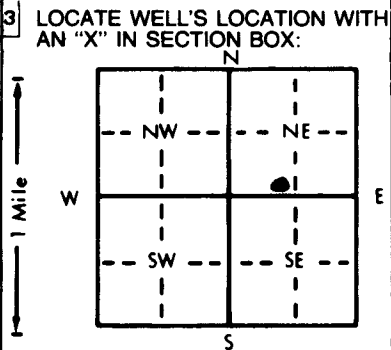

4 DEPTH OF COMPLETED WELL: 15'6" ft. ELEVATION: ..... ft.  
 Depth(s) Groundwater Encountered: 1. 7' ft. 2. .... ft. 3. .... ft.  
 WELL'S STATIC WATER LEVEL: 6.42 ft. below land surface measured on mo/day/yr 4-17-95  
 Pump test data: Well water was ..... ft. after ..... hours pumping ..... gpm  
 Est. Yield ..... gpm: Well water was ..... ft. after ..... hours pumping ..... gpm  
 Bore Hole Diameter: 8 1/2" in. to 15'6" ft., and ..... in. to ..... ft.  
 WELL WATER TO BE USED AS:  
 1 Domestic 3 Feedlot 6 Oil field water supply 9 Dewatering 12 Other (Specify below)  
 2 Irrigation 4 Industrial 7 Lawn and garden only 10 Monitoring well  
 Was a chemical/bacteriological sample submitted to Department? Yes.....No X.....; If yes, mo/day/yr sample was submitted  
 Water Well Disinfected? Yes No

5 TYPE OF BLANK CASING USED:  
 1 Steel 3 RMP (SR) 5 Wrought iron 8 Concrete tile CASING JOINTS: Glued ..... Clamped .....  
2 PVC 4 ABS 6 Asbestos-Cement 9 Other (specify below) Welded .....  
 7 Fiberglass Threaded..... X  
 Blank casing diameter 2.375 in. to 5' ft., Dia ..... in. to ..... ft., Dia ..... in. to SDR 13 ft.  
 Casing height above land surface Flush Mount in., weight ..... lbs./ft. Wall thickness or gauge No. SCH 40  
 TYPE OF SCREEN OR PERFORATION MATERIAL:  
 1 Steel 3 Stainless steel 5 Fiberglass 8 RMP (SR) 11 Other (specify) .....  
 2 Brass 4 Galvanized steel 6 Concrete tile 9 ABS 12 None used (open hole)  
 SCREEN OR PERFORATION OPENINGS ARE:  
 1 Continuous slot 3 Mill slot 5 Gauzed wrapped 8 Saw cut 11 None (open hole)  
 2 Louvered shutter 4 Key punched 6 Wire wrapped 9 Drilled holes  
 7 Torch cut 10 Other (specify) .....  
 SCREEN-PERFORATED INTERVALS: From 15' ft. to 5' ft., From ..... ft. to ..... ft.  
 From ..... ft. to ..... ft., From ..... ft. to ..... ft.  
 GRAVEL PACK INTERVALS: From 15'6" ft. to 4' ft., From ..... ft. to ..... ft.  
 From ..... ft. to ..... ft., From ..... ft. to ..... ft.

6 GROUT MATERIAL: 1 Neat cement 2 Cement grout 3 Bentonite 4 Other  
 Grout Intervals: From 4' ft. to 3' ft., From 3' ft. to 6' ft., From ..... ft. to ..... ft.  
 What is the nearest source of possible contamination:  
 1 Septic tank 4 Lateral lines 7 Pit privy 11 Fuel storage Product Island 14 Abandoned water well  
 2 Sewer lines 5 Cess pool 8 Sewage lagoon 12 Fertilizer storage 15 Oil well/Gas well  
 3 Watertight sewer lines 6 Seepage pit 9 Feedyard 13 Insecticide storage 16 Other (specify below)  
 Direction from well? North How many feet? 15'

FROM	TO	LITHOLOGIC LOG	FROM	TO	PLUGGING INTERVALS
0	.75	Concrete			
.75	3	Olive green silty clay, moist, soft, mod. odor.			
3	8	Blk. silty clay w/ concr., brick rubble, moist to wet, strong odor w/ dk green clay mottling.			
8	12	Med brn-dk brn silty clay w/ gray green clay mottling, iron oxides, mod. odor, moist, firm.			
12	15'6"	Green olive silty clay w/ dk. gray to blk. clay stringers, wet, sheen on water, firm to soft, very strong odor.			

7 CONTRACTOR'S OR LANDOWNER'S CERTIFICATION: This water well was (1) constructed (2) reconstructed, or (3) plugged under my jurisdiction and was completed on (mo/day/year) 4-6-95 and this record is true to the best of my knowledge and belief. Kansas Water Well Contractor's License No. 539 This Water Well Record was completed on (mo/day/yr) 4-18-95 under the business name of JB Environmental Drilling by (signature) James Beebe

INSTRUCTIONS: Use typewriter or ball point pen. PLEASE PRESS FIRMLY and PRINT clearly. Please fill in blanks, underline or circle the correct answers. Send top three copies to Kansas Department of Health and Environment, Bureau of Water, Topeka, Kansas 66620-0001. Telephone: 913-296-5545. Send one to WATER WELL OWNER and retain one for your records.