


1 LOCATION OF WATER WELL: Fraction NE 1/4 NW 1/4 SE 1/4 Section Number 35 Township Number T 8 S Range Number R 22 EW
 County: Leavenworth

Distance and direction from nearest town or city street address of well if located within city?
788 Spruce, Leavenworth, Ks.

2 WATER WELL OWNER: Wood's Mini Mart
 RR#, St. Address, Box #: 788 Spruce P.O. Box 67 Board of Agriculture, Division of Water Resources
 City, State, ZIP Code: Leavenworth, Ks. 66048 Application Number:

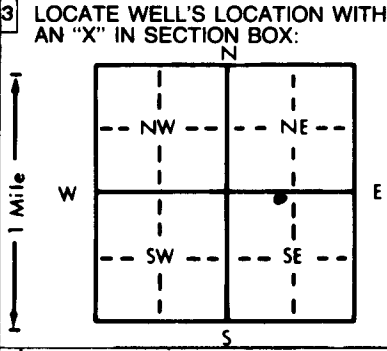

4 DEPTH OF COMPLETED WELL... 15'6" ft. ELEVATION: ft.
 Depth(s) Groundwater Encountered 1. 6' ft. 2. ft. 3. ft.
 WELL'S STATIC WATER LEVEL 5.12 ft. below land surface measured on mo/day/yr 4-17-95
 Pump test data: Well water was ft. after hours pumping gpm
 Est. Yield gpm; Well water was ft. after hours pumping gpm
 Bore Hole Diameter... 8 1/2" in. to 15'6" ft., and in. to ft.
 WELL WATER TO BE USED AS:
 5 Public water supply 8 Air conditioning 11 Injection well
 1 Domestic 3 Feedlot 6 Oil field water supply 9 Dewatering 12 Other (Specify below)
 2 Irrigation 4 Industrial 7 Lawn and garden only 10 Monitoring well
 Was a chemical/bacteriological sample submitted to Department? Yes..... No X.....; If yes, mo/day/yr sample was submitted
 Water Well Disinfected? Yes No

5 TYPE OF BLANK CASING USED:
 1 Steel 2 PVC 3 RMP (SR) 4 ABS 5 Wrought iron 6 Asbestos-Cement 7 Fiberglass 8 Concrete tile 9 Other (specify below) CASING JOINTS: Glued Clamped
 Welded Threaded X
 Blank casing diameter 2.375 in. to 5' ft., Dia in. to ft., Dia in. to SDR 13 ft.
 Casing height above land surface Flush Head in., weight lbs./ft. Wall thickness or gauge No. SCH 40
 TYPE OF SCREEN OR PERFORATION MATERIAL:
 1 Steel 3 Stainless steel 5 Fiberglass 8 RMP (SR) 10 Asbestos-cement 11 Other (specify)
 2 Brass 4 Galvanized steel 6 Concrete tile 9 ABS 12 None used (open hole)
 SCREEN OR PERFORATION OPENINGS ARE:
 1 Continuous slot 3 Mill slot 3 4 Key punched 5 Gauzed wrapped 6 Wire wrapped 7 Torch cut 8 Saw cut 11 None (open hole)
 2 Louvered shutter 4 Key punched 7 Torch cut 10 Other (specify)
 SCREEN-PERFORATED INTERVALS: From 15' ft. to 5' ft., From ft. to ft.
 From ft. to ft., From ft. to ft.
 GRAVEL PACK INTERVALS: From 15'6" ft. to 4' ft., From ft. to ft.
 From ft. to ft., From ft. to ft.

6 GROUT MATERIAL:
 1 Neat cement 2 Cement grout 3 3 Bentonite 4 Other
 Grout Intervals: From 4' ft. to 3' ft., From 3' ft. to 0' ft., From ft. to ft.
 What is the nearest source of possible contamination:
 1 Septic tank 4 Lateral lines 7 Pit privy 11 Fuel storage 10 Livestock pens 14 Abandoned water well
 2 Sewer lines 5 Cess pool 8 Sewage lagoon 12 Fertilizer storage 15 Oil well/Gas well
 3 Watertight sewer lines 6 Seepage pit 9 Feedyard 13 Insecticide storage 16 Other (specify below)
 Direction from well? North How many feet? 70'

FROM	TO	LITHOLOGIC LOG	FROM	TO	PLUGGING INTERVALS
0	3.50	Grass dk brn loamy silty soil, soft, roots, earthy odor.			
3.50	9	Dk brn silty clay, firm, moist to wet, earthy odor.			
9	13.75	Brn silty clay w/ greenish gray mottling, moist to wet at 11', odor-faint to mod.			
13.75	15'6"	Tan brn silty clay, moist to wet, mottled, soft, no odor.			

7 CONTRACTOR'S OR LANDOWNER'S CERTIFICATION: This water well was (1) constructed (2) reconstructed, or (3) plugged under my jurisdiction and was completed on (mo/day/year) 4-12-95 and this record is true to the best of my knowledge and belief. Kansas Water Well Contractor's License No. 539 This Water Well Record was completed on (mo/day/yr) 4-18-95 under the business name of JB Environmental Drilling by (signature) James Buehli