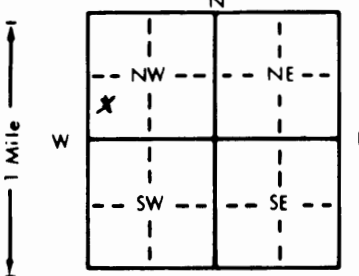


MW-1 2311016

1 LOCATION OF WATER WELL: County: <u>CLAY</u>	Fraction <u>NW 1/4 SW 1/4 NW 1/4</u>	Section Number <u>8</u>	Township Number <u>T 8 S</u>	Range Number <u>R 3 E</u>
--	---	----------------------------	---------------------------------	------------------------------

Distance and direction from nearest town or city street address of well if located within city?  
EAST SIDE OF 6th STREET IN DEXTER PARK

2 WATER WELL OWNER: KDHE  
 RR#, St. Address, Box #: FORBES FIELD BUILDING 740  
 City, State, ZIP Code: TOPEKA, KS 66620  
 Board of Agriculture, Division of Water Resources  
 Application Number:

3 LOCATE WELL'S LOCATION WITH AN "X" IN SECTION BOX:  


4 DEPTH OF COMPLETED WELL: 3.5 ft. ELEVATION:  
 Depth(s) Groundwater Encountered 1. 2.2 ft. 2. ft. 3. ft.  
 WELL'S STATIC WATER LEVEL 24.84 ft. below land surface measured on mo/day/yr 6-20-95  
 Pump test data: Well water was ft. after hours pumping gpm  
 Est. Yield gpm; Well water was ft. after hours pumping gpm  
 Bore Hole Diameter . in. to . ft., and . in. to . ft.  
 WELL WATER TO BE USED AS:  
 5 Public water supply 8 Air conditioning 11 Injection well  
 1 Domestic 3 Feedlot 6 Oil field water supply 9 Dewatering 12 Other (Specify below)  
 2 Irrigation 4 Industrial 7 Lawn and garden only 10 Monitoring well  
 Was a chemical/bacteriological sample submitted to Department? Yes No X; If yes, mo/day/yr sample was submitted  
 Water Well Disinfected? Yes No X

5 TYPE OF BLANK CASING USED:  
 1 Steel 3 RMP (SR) 5 Wrought iron 8 Concrete tile CASING JOINTS: Glued Clamped  
2 PVC 4 ABS 6 Asbestos-Cement 9 Other (specify below) Welded  
 7 Fiberglass Threaded FLUSH  
 Blank casing diameter 2.0 in. to . ft., Dia . in. to . ft., Dia . in. to . ft.  
 Casing height above land surface FLUSH in., weight 7.03 lbs./ft. Wall thickness or gauge No. 154  
 TYPE OF SCREEN OR PERFORATION MATERIAL:  
 1 Steel 3 Stainless steel 5 Fiberglass 8 RMP (SR) 10 Asbestos-cement  
 2 Brass 4 Galvanized steel 6 Concrete tile 9 ABS 12 None used (open hole)  
 SCREEN OR PERFORATION OPENINGS ARE:  
 1 Continuous slot 3 Mill slot 5 Gauzed wrapped 8 Saw cut 11 None (open hole)  
 2 Louvered shutter 4 Key punched 6 Wire wrapped 9 Drilled holes  
 7 Torch cut 10 Other (specify)  
 SCREEN-PERFORATED INTERVALS: From 3.0 ft. to 3.5 ft., From . ft. to . ft.  
 From . ft. to . ft., From . ft. to . ft.  
 GRAVEL PACK INTERVALS: From 2.8 ft. to 3.5 ft., From . ft. to . ft.  
 From . ft. to . ft., From . ft. to . ft.

6 GROUT MATERIAL: 1 Neat cement 2 Cement grout 3 Bentonite 4 Other  
 Grout Intervals: From 2.8 ft. to . ft., From . ft. to . ft., From . ft. to . ft.  
 What is the nearest source of possible contamination:  
 1 Septic tank 4 Lateral lines 7 Pit privy 10 Livestock pens 14 Abandoned water well  
 2 Sewer lines 5 Cess pool 8 Sewage lagoon 11 Fuel storage 15 Oil well/Gas well  
 3 Watertight sewer lines 6 Seepage pit 9 Feedyard 12 Fertilizer storage 16 Other (specify below)  
 13 Insecticide storage  
 Direction from well? How many feet?

FROM	TO	LITHOLOGIC LOG	FROM	TO	PLUGGING INTERVALS
1.0	12.0	CLAY, SILTY			
12.0	16.0	CLAY, V. SILTY			
16.0	21.0	SAND, V. SILTY, CLAYEY			
21.0	27.5	SAND, WITH GRAVEL			
27.5	35.0	SAND, WITH GRAVEL			

7 CONTRACTOR'S OR LANDOWNER'S CERTIFICATION: This water well was (1) constructed (2) reconstructed, or (3) plugged under my jurisdiction and was completed on (mo/day/year) 6-20-95 and this record is true to the best of my knowledge and belief. Kansas Water Well Contractor's License No. 531 This Water Well Record was completed on (mo/day/yr) 7-5-95 under the business name of GSI by (signature) Steve Neudler

OFFICE USE ONLY  
T  
R  
EW  
SEC.  
1/4  
1/4  
1/4