


1 LOCATION OF WATER WELL:	Fraction	Section Number	Township Number	Range Number
County: Clay	SE ¼ SW ¼ NW ¼	8	T 8 S	R 3 (EW)

Distance and direction from nearest town or city street address of well if located within city?
330 Grant Street - Clay Center, KS

2 WATER WELL OWNER: Don's Electronics RR#, St. Address, Box # : 330 Grant Street City, State, ZIP Code : Clay Center, Kansas 67432	Board of Agriculture, Division of Water Resources Application Number:
---	--

3 LOCATE WELL'S LOCATION WITH AN "X" IN SECTION BOX:

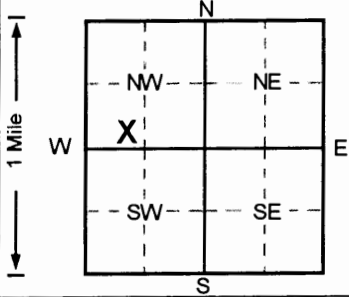

4 DEPTH OF COMPLETED WELL 35 ft. ELEVATION: 1197.52	Depth(s) Groundwater Encountered 1 29 ft. 2 ft. 3 ft.
WELL'S STATIC WATER LEVEL . . . 25.28 . . . ft. below land surface measured on mo/day/yr . . . 6/18/96 . . .	
Pump test data: Well water was . . . NA . . . ft. after hours pumping gpm	
Est. Yield . . . NA . . . gpm; Well water was ft. after hours pumping gpm	
Bore Hole Diameter . . . 8 . . . in. to 35 ft., and in. to ft.	
WELL WATER TO BE USED AS: 5 Public water supply 8 Air conditioning 11 Injection well	
1 Domestic 3 Feedlot 6 Oil field water supply 9 Dewatering 12 Other (Specify below)	
2 Irrigation 4 Industrial 7 Lawn and garden only (10) Monitoring well	
Was a chemical/bacteriological sample submitted to Department? Yes.....No.....; If yes, mo/day/yr sample was submitted	
Water Well Disinfected? Yes No (checked)	

5 TYPE OF BLANK CASING USED:	CASING JOINTS: Glued Clamped
1 Steel 3 RMP (SR) (2) PVC 4 ABS	Welded Threaded. (checked)
Blank casing diameter 2 in. to 20 ft., Dia in. to ft., Dia in. to ft.	5 Wrought iron 8 Concrete tile 6 Asbestos-Cement 9 Other (specify below)
Casing height above land surface -3.36 in., weight lbs./ft. Wall thickness or gauge No. Sch. 40	

TYPE OF SCREEN OR PERFORATION MATERIAL	(7) PVC 10 Asbestos-cement
1 Steel 3 Stainless steel 5 Fiberglass 8 RMP (SR) 11 Other (specify)	2 Brass 4 Galvanized steel 6 Concrete tile 9 ABS 12 None used (open hole)
SCREEN OR PERFORATION OPENINGS ARE:	5 Gauzed wrapped 8 Saw cut 11 None (open hole)
1 Continuous slot (3) Mill slot 6 Wire wrapped 9 Drilled holes	2 Louvered shutter 4 Key punched 7 Torch cut 10 Other (specify)
SCREEN-PERFORATED INTERVALS: From 20 ft. to 35 ft., From ft. to ft., From ft. to ft.	
GRAVEL PACK INTERVALS: From 18 ft. to 35 ft., From ft. to ft., From ft. to ft.	

6 GROUT MATERIAL:	1 Neat cement (2) Cement grout (3) Bentonite 4 Other
Grout Intervals: From 0 ft. to 16 ft., From 16 ft. to 18 ft., From ft. to ft.	
What is the nearest source of possible contamination:	10 Livestock pens 14 Abandoned water well
1 Septic tank 4 Lateral lines 7 Pit privy 8 Sewage lagoon 12 Fertilizer storage (16) Other (specify below)	15 Oil well/Gas well
2 Sewer lines 5 Cess pool 9 Feedyard 13 Insecticide storage	(16) Other (specify below): UST Basin
3 Watertight sewer lines 6 Seepage pit	
Direction from well? NW	How many feet? 1300

FROM	TO	LITHOLOGIC LOG	FROM	TO	PLUGGING INTERVALS
0	0.5	1/2" Gravel/Topsoil,			
0.5	8	Clay, Dark Brown			
8	15	Silt, Brown			
15	23	Silt, Brown			
23	35	Sand, Brown			

MW13, Tag # 00160407, Flushmount
 Project Name: **Don's Electronics**
 GeoCore # 300, KDHE # U5 014 10314

7 CONTRACTOR'S OR LANDOWNER'S CERTIFICATION: This water well was (1) constructed, (2) reconstructed, or (3) plugged under my jurisdiction and was completed on (mo/day/year) 5/30/96 and this record is true to the best of my knowledge and belief.	
Kansas Water Well Contractor's License No. 527 This Water Well Record was completed on (mo/day/yr) 6/14/96 under the business name of GeoCore Services, Inc. by (signature) <i>Dale Kell</i>	

INSTRUCTIONS: Use typewriter or ball point pen. PLEASE PRESS FIRMLY and PRINT clearly. Please fill in blanks, underline or circle the correct answers. Send top three copies to Kansas Department of Health and Environment, Bureau of Water, Topeka, Kansas 66620-0001. Telephone: 913-296-5545. Send one to WATER WELL OWNER and retain one for your records.

OFFICE USE ONLY T R SEC ¼ ½