


1 LOCATION OF WATER WELL: Fraction NE 1/4 SW 1/4 NW 1/4 Section Number 8 Township Number T 8 S Range Number R 3 E/W

Distance and direction from nearest town or city street address of well if located within city? 330 Grant Street - Clay Center, KS

2 WATER WELL OWNER: Don's Electronics RR#, St. Address, Box #: 330 Grant Street City, State, ZIP Code: Clay Center, Kansas 67432 Board of Agriculture, Division of Water Resources Application Number:

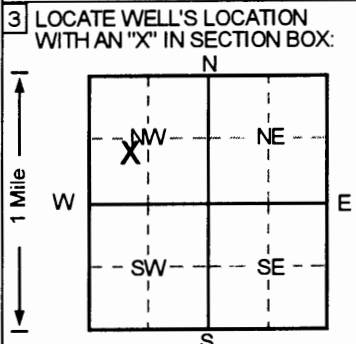

4 DEPTH OF COMPLETED WELL: 35 ft. ELEVATION: 1198.45 ft. WELL'S STATIC WATER LEVEL: 25.77 ft. below land surface measured on 6/18/96

5 TYPE OF BLANK CASING USED: 2 PVC Blank casing diameter: 2 in. to 20 ft. Dia. Casing height above land surface: -2.76 in., weight: lbs./ft. Wall thickness or gauge No. Sch. 40

TYPE OF SCREEN OR PERFORATION MATERIAL: 7 PVC SCREEN OR PERFORATION OPENINGS ARE: 3 Mill slot SCREEN-PERFORATED INTERVALS: From 20 ft. to 35 ft.

GRAVEL PACK INTERVALS: From 18 ft. to 35 ft. GROUT MATERIAL: 2 Cement grout, 3 Bentonite Grout intervals: From 0 ft. to 16 ft., From 16 ft. to 18 ft.

What is the nearest source of possible contamination: 16 Other (specify below) UST Basin. Direction from well? SW

Table with columns: FROM, TO, LITHOLOGIC LOG, FROM, TO, PLUGGING INTERVALS. Rows include: 0 to 0.5 Vegetation/Topsoil, 0.5 to 7 Clay, Dark Brown, 7 to 14 Silt, Brown, 14 to 23 Silt, Gray Brown, 23 to 35 Sand, Brown. Bottom rows: MW18, Tag # 00163840, Flushmount; Project Name: Don's Electronics; GeoCore # 300, KDHE # U5 014 10314

7 CONTRACTOR'S OR LANDOWNER'S CERTIFICATION: This water well was (1) constructed, (2) reconstructed, or (3) plugged under my jurisdiction and was completed on (mo/day/year) 6/6/96 and this record is true to the best of my knowledge and belief. Kansas Water Well Contractor's License No. 527 This Water Well Record was completed on (mo/day/yr) 6/14/96 under the business name of GeoCore Services, Inc. by (signature)

INSTRUCTIONS: Use typewriter or ball point pen. PLEASE PRESS FIRMLY and PRINT clearly. Please fill in blanks, underline or circle the correct answers. Send top three copies to Kansas Department of Health and Environment, Bureau of Water, Topeka, Kansas 66620-0001. Telephone: 913-296-5545. Send one to WATER WELL OWNER and retain one for your records.