


1 LOCATION OF WATER WELL: County: Clay Fraction SE 1/4 SE 1/4 NE 1/4 Section Number 7 Township Number T 8 S Range Number R 3 E/W

Distance and direction from nearest town or city street address of well if located within city?

330 Grant Street - Clay Center, KS

2 WATER WELL OWNER: Don's Electronics RR#, St. Address, Box #: 330 Grant Street City, State, ZIP Code: Clay Center, Kansas 67432 Board of Agriculture, Division of Water Resources Application Number:

3 LOCATE WELL'S LOCATION WITH AN 'X' IN SECTION BOX:

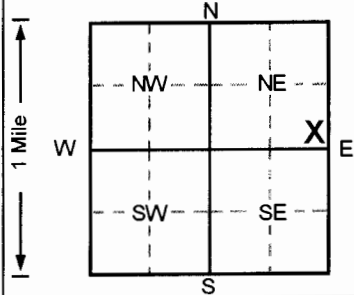

4 DEPTH OF COMPLETED WELL: 27 ft. ELEVATION: 999. Depth(s) Groundwater Encountered 1. 999 ft. 2. ft. 3. ft. WELL'S STATIC WATER LEVEL: 999 ft. below land surface measured on mo/day/yr Pump test data: Well water was NA ft. after hours pumping gpm Est. Yield NA gpm: Well water was ft. after hours pumping gpm Bore Hole Diameter: 8 in. to 30 ft., and in. to ft. WELL WATER TO BE USED AS: 5 Public water supply 8 Air conditioning 11 Injection well 1 Domestic 3 Feedlot 6 Oil field water supply 9 Dewatering 12 Other (Specify below) Vapor Observation 2 Irrigation 4 Industrial 7 Lawn and garden only 10 Monitoring well Was a chemical/bacteriological sample submitted to Department? Yes No checked; If yes, mo/day/yr sample was submitted Water Well Disinfected? Yes No checked

5 TYPE OF BLANK CASING USED: 1 Steel 2 PVC 3 RMP (SR) 4 ABS 5 Wrought iron 6 Asbestos-Cement 7 Fiberglass 8 Concrete tile 9 Other (specify below) CASING JOINTS: Glued Clamped Welded Threaded checked Blank casing diameter 2 in. to 17 ft. Dia in. to ft. Dia in. to ft. Casing height above land surface 0 in., weight lbs./ft. Wall thickness or gauge No. Sch. 40

TYPE OF SCREEN OR PERFORATION MATERIAL: 1 Steel 2 Brass 3 Stainless steel 4 Galvanized steel 5 Fiberglass 6 Concrete tile 7 PVC 8 RMP (SR) 9 ABS 10 Asbestos-cement 11 Other (specify) 12 None used (open hole)

SCREEN OR PERFORATION OPENINGS ARE: 1 Continuous slot 2 Louvered shutter 3 Mill slot 4 Key punched 5 Gauzed wrapped 6 Wire wrapped 7 Torch cut 8 Saw cut 9 Drilled holes 10 Other (specify) 11 None (open hole)

SCREEN-PERFORATED INTERVALS: From 17 ft. to 27 ft., From ft. to ft., From ft. to ft. GRAVEL PACK INTERVALS: From 15 ft. to 30 ft., From ft. to ft., From ft. to ft.

6 GROUT MATERIAL: 1 Neat cement 2 Cement grout 3 Bentonite 4 Other Grout Intervals: From 0 ft. to 13 ft., From 13 ft. to 15 ft., From ft. to ft. What is the nearest source of possible contamination: 1 Septic tank 2 Sewer lines 3 Watertight sewer lines 4 Lateral lines 5 Cess pool 6 Seepage pit 7 Pit privy 8 Sewage lagoon 9 Feedyard 10 Livestock pens 11 Fuel storage 12 Fertilizer storage 13 Insecticide storage 14 Abandoned water well 15 Oil well/Gas well 16 Other (specify below) UST Basin

Direction from well? LITHOLOGIC LOG FROM TO Clay, Dark Brown 0 6 Clay, Brown 6 12 Silt, Light Brown 12 17 Sand, Light Brown to Light Gray 17 27 Sand, Dark Gray to Gray Green 27 30 PLUGGING INTERVALS FROM TO VOB1, Flushmount Project Name: Don's Electronics GeoCore # 300, KDHE # U5 014 10314

7 CONTRACTOR'S OR LANDOWNER'S CERTIFICATION: This water well was (1) constructed, (2) reconstructed, or (3) plugged under my jurisdiction and was completed on (mo/day/year) 7/22/96 and this record is true to the best of my knowledge and belief. Kansas Water Well Contractor's License No. 527 This Water Well Record was completed on (mo/day/yr) 7/31/96 under the business name of GeoCore Services, Inc. by (signature) Paul Koll

INSTRUCTIONS: Use typewriter or ball point pen. PLEASE PRESS FIRMLY and PRINT clearly. Please fill in blanks, underline or circle the correct answers. Send top three copies to Kansas Department of Health and Environment, Bureau of Water, Topeka, Kansas 66620-0001. Telephone: 913-296-5545. Send one to WATER WELL OWNER and retain one for your records.

OFFICE USE ONLY T R EW SEC 1/4 1/4