


1 LOCATION OF WATER WELL: County: Clay Fraction: SE 1/4 SE 1/4 SE 1/4 Section Number: 26 Township Number: T 8 S Range Number: R 3 E/W

Distance and direction from nearest town or city street address of well if located within city? From Clay Center Co 3 miles East on CN County Rd.

2 WATER WELL OWNER: Mr. Don Martin RR#, St. Address, Box #: RR City, State, ZIP Code: Clay Center, KS 67432 Board of Agriculture, Division of Water Resources Application Number:

3 LOCATE WELL'S LOCATION WITH AN "X" IN SECTION BOX:

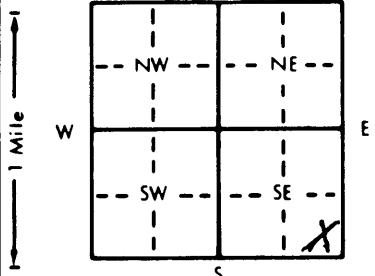

4 DEPTH OF COMPLETED WELL: 45 ft. ELEVATION: Depth(s) Groundwater Encountered: 1. 24 ft. 2. ft. 3. ft. WELL'S STATIC WATER LEVEL: 17 ft. below land surface measured on mo/day/yr Pump test data: Well water was ft. after hours pumping gpm Est. Yield: 50 gpm; Well water was ft. after hours pumping gpm Bore Hole Diameter: 10 in. to 45 ft., and in. to ft. WELL WATER TO BE USED AS: 5 Public water supply 8 Air conditioning 11 Injection well 1 Domestic 3 Feedlot 6 Oil field water supply 9 Dewatering 12 Other (Specify below) 2 Irrigation 4 Industrial 7 Lawn and garden only 10 Monitoring well Was a chemical/bacteriological sample submitted to Department? Yes No; If yes, mo/day/yr sample was submitted Water Well Disinfected: Yes No

5 TYPE OF BLANK CASING USED: 1 PVC 3 RMP (SR) 6 Asbestos-Cement 9 Other (specify below) Welded Threaded 2 Steel 4 ABS 7 Fiberglass CASING JOINTS: Glued Clamped

Blank casing diameter: 5 in. to 31 25 ft. Dia. in. to ft. Dia. in. to ft. Casing height above land surface: 31 in., weight sch. 40 lbs./ft. Wall thickness or gauge No.

TYPE OF SCREEN OR PERFORATION MATERIAL: 1 Steel 3 Stainless steel 5 Fiberglass 8 RMP (SR) 11 Other (specify) 2 Brass 4 Galvanized steel 6 Concrete tile 9 ABS 12 None used (open hole) 7 PVC 10 Asbestos-cement

SCREEN OR PERFORATION OPENINGS ARE: 1 Continuous slot 3 Mill slot 10 1000's 5 Gauzed wrapped 8 Saw cut 11 None (open hole) 2 Louvered shutter 4 Key punched 6 Wire wrapped 9 Drilled holes 7 Torch cut 10 Other (specify)

SCREEN-PERFORATED INTERVALS: From 2.5 ft. to 4.5 ft., From ft. to ft. From ft. to ft. From ft. to ft. GRAVEL PACK INTERVALS: From 2.5 ft. to 4.5 ft., From ft. to ft. From ft. to ft. From ft. to ft.

6 GROUT MATERIAL: 1 Neat cement 2 Cement grout 3 Bentonite 4 Other Grout intervals: From 0 ft. to 2.5 ft., From ft. to ft. From ft. to ft. From ft. to ft.

What is the nearest source of possible contamination: None Close 10 Livestock pens 14 Abandoned water well 1 Septic tank 4 Lateral lines 7 Pit privy 11 Fuel storage 15 Oil well/Gas well 2 Sewer lines 5 Cess pool 8 Sewage lagoon 12 Fertilizer storage 16 Other (specify below) 3 Watertight sewer lines 6 Seepage pit 9 Feedyard 13 Insecticide storage

Direction from well? How many feet?

FROM	TO	LITHOLOGIC LOG	FROM	TO	PLUGGING INTERVALS
0	1	Top Soil			
1	24	Sandy Clay			
24	30	Fine Sand (Water)			
30	33	Medium Sand			
33	45	Coarse Sand			

7 CONTRACTOR'S OR LANDOWNER'S CERTIFICATION: This water well was (1) constructed, (2) reconstructed, or (3) plugged under my jurisdiction and was completed on (mo/day/year) 10/8/96 and this record is true to the best of my knowledge and belief. Kansas Water Well Contractor's License No. 451 This Water Well Record was completed on (mo/day/year) 10/22/96 under the business name of Holdman Well Drilling by (signature) Craig Holdman