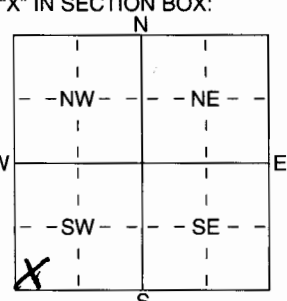


1 LOCATION OF WATER WELL: Fraction SW 1/4 SW 1/4 SW 1/4 Section Number 5 Township Number T 8 S Range Number R 3 EDW
 County: CLAY

Distance and direction from nearest town or city street address of well if located within city?
3 BLOCK SOUTH OF HWY 15/24 INTERSECTION FW CLAY CENTER, EAST SIDE OF HWY 15/24.

2 WATER WELL OWNER: TWIN VALLEY TELEPHONE FW.
 RR#, St. Address, Box # : 22 SARJUE Board of Agriculture, Division of Water Resources
 City, State, ZIP Code : MELDORVALE, KS. 67466 Application Number: _____

3 LOCATE WELL'S LOCATION WITH AN "X" IN SECTION BOX:

 4 DEPTH OF COMPLETED WELL _____ ft. ELEVATION: _____
 Depth(s) Groundwater Encountered 1 31 ft. 2 _____ ft. 3 _____ ft.
 WELL'S STATIC WATER LEVEL 2.6 ft. below land surface measured on mo/day/yr 2/15/06
 Pump test data: Well water was _____ ft. after _____ hours pumping _____ gpm
 Est. Yield _____ gpm: Well water was _____ ft. after _____ hours pumping _____ gpm
 WELL WATER TO BE USED AS: 5 Public water supply 8 Air conditioning 11 Injection well
 1 Domestic 3 Feedlot 6 Oil field water supply 9 Dewatering 12 Other (Specify below)
 2 Irrigation 4 Industrial 7 Domestic (lawn & garden) 10 Monitoring well GEOTHERMAL
 Was a chemical/bacteriological sample submitted to Department? Yes _____ No X; If yes, mo/day/yr sample was submitted
 Water Well Disinfected? Yes X No _____

5 TYPE OF BLANK CASING USED: 5 Wrought iron 8 Concrete tile CASING JOINTS: Glued X Clamped _____
 1 Steel 3 RMP (SR) 6 Asbestos-Cement 9 Other (specify below) Welded _____
2 PVC 4 ABS 7 Fiberglass Threaded _____
 Blank casing diameter 5 in. to 5.5 ft., Dia _____ in. to _____ ft., Dia _____ in. to _____ ft.
 Casing height above land surface 24 in., weight _____ lbs./ft. Wall thickness or guage No. SAR 21
 TYPE OF SCREEN OR PERFORATION MATERIAL: 10 Asbestos-Cement
 1 Steel 3 Stainless Steel 5 Fiberglass 7 PVC 8 RMP (SR) 11 Other (Specify) _____
 2 Brass 4 Galvanized Steel 6 Concrete tile 9 ABS 12 None used (open hole)
 SCREEN OR PERFORATION OPENINGS ARE: 5 Gauzed wrapped 8 Saw cut 11 None (open hole)
 1 Continuous slot Mill slot 6 Wire wrapped 9 Drilled holes
 2 Louvered shutter 4 Key punched 7 Torch cut 10 Other (specify) _____ ft.
 SCREEN-PERFORATED INTERVALS: From 5.5 ft. to 7.5 ft., From _____ ft. to _____ ft.
 From _____ ft. to _____ ft., From _____ ft. to _____ ft.
 GRAVEL PACK INTERVALS: From 2.5 ft. to 7.5 ft., From _____ ft. to _____ ft.
 From _____ ft. to _____ ft., From _____ ft. to _____ ft.

6 GROUT MATERIAL: 1 Neat cement 2 Cement grout Bentonite 4 Other _____
 Grout intervals: From 3 ft. to 2.5 ft., From _____ ft. to _____ ft., From _____ ft. to _____ ft.
 What is the nearest source of possible contamination:
 1 Septic tank 4 Lateral lines 7 Pit privy 10 Livestock pens 14 Abandoned water well
2 Sewer lines 5 Cess pool 8 Sewage lagoon 11 Fuel storage 15 Oil well/Gas well
 3 Watertight sewer lines 6 Seepage pit 9 Feedyard 12 Fertilizer storage 16 Other (specify below)
 13 Insecticide storage _____
 Direction from well? EAST How many feet? 30

FROM	TO	LITHOLOGIC LOG	FROM	TO	PLUGGING INTERVALS
0	8	SOFT CLAY			
8	30	CLAY/SANDY CLAY			
30	31	SANDY CLAY			
31	35	SAND			
35	66	SAND, COARSE, TRAP GRAVEL			
66	67	LEMPSONITE			
67	67	SHALE, GRAY			
67	75	LEMPSONITE			

7 CONTRACTOR'S OR LANDOWNER'S CERTIFICATION: This water well was (1) constructed, (2) reconstructed, or (3) plugged under my jurisdiction and was completed on (mo/day/year) 2/15/06 and this record is true to the best of my knowledge and belief. Kansas Water Well Contractor's Licence No 760 This Water Well Record was completed on (mo/day/yr) 3/14/06 under the business name of ASSOCIATED DRILLING INC. by (signature) _____