


1 LOCATION OF WATER WELL:	Fraction	Section Number	Township Number	Range Number
County: CLAY	$\frac{1}{4}$ SW $\frac{1}{4}$ NE $\frac{1}{4}$ SW	18	T 8 S	R 3 E E/W

Distance and direction from nearest town or city street address of well if located within city?
ONE MILE SOUTH + 3/4 MILE WEST OF CLAY CENTER

2 WATER WELL OWNER: STEVE PETERSON	Board of Agriculture, Division of Water Resources
RR #, St. Address, Box #: 1931 4th ST.	Application Number:
City, State, ZIP Code: CLAY CENTER KS	

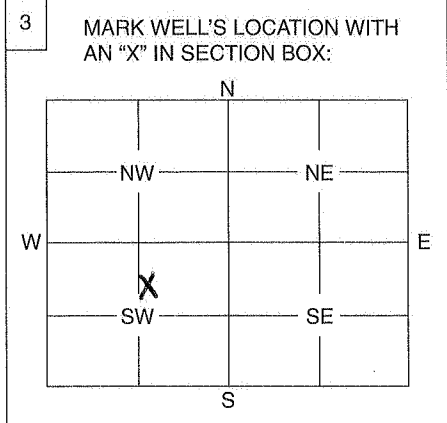

4 DEPTH OF WELL **37' - 6"** ft.

WELL'S STATIC WATER LEVEL **NONE** ft.

WELL WAS USED AS:

<input checked="" type="checkbox"/> 1 Domestic	5 Public Water Supply	9 Dewatering
<input type="checkbox"/> 2 Irrigation	6 Oil Field Water Supply	10 Monitoring Well
<input type="checkbox"/> 3 Feedlot	7 Domestic (Lawn & Garden)	11 Injection Well
<input type="checkbox"/> 4 Industrial	8 Air Conditioning	12 Other

Was a chemical / bacteriological sample submitted to Department? Yes No

If yes, mo/day/yr sample was submitted

Water Well Disinfected: Yes No

5 TYPE OF BLANK CASING USED:

<input checked="" type="checkbox"/> 1 Steel	3 RMP (SR)	5 Wrought	7 Fiberglass	9 Other (Specify below)
<input type="checkbox"/> 2 PVC	4 ABS	6 Asbestos-Cement	8 Concrete Tile	

Blank casing diameter **5 1/2** in. Was casing pulled? Yes No

Casing height above or below land surface **48** in. **BELOW** If yes, how much

6 GROUT PLUG MATERIAL: 1 Neat cement 2 Cement grout 3 Bentonite 4 Other

Grout Plug Intervals: From ft. to ft., From ft. to ft., From to ft.

What is the nearest source of possible contamination:

1 Septic tank	6 Seepage pit	11 Fuel storage	16 Other (specify below)
2 Sewer lines	7 Pit privy	12 Fertilizer storage	NONE
3 Watertight sewer lines	8 Sewage lagoon	13 Insecticide storage	
4 Lateral lines	9 Feedyard	<input checked="" type="checkbox"/> 14 Abandoned water well PLUGGED	
5 Cess pool	10 Livestock pens	15 Oil well/Gas well	

Direction from well? **NORTH** How many feet? **15**

FROM	TO	PLUGGING MATERIALS
4 FT	37 1/2 FT	BENTONITE

GPS INFORMATION
39.356194 - LATITUDE
-97.14227 - LONGITUDE

DROID RAZR M
EST ACCURACY 5-15 M

7 CONTRACTOR'S OF LANDOWNER'S CERTIFICATION: This water well was plugged under my jurisdiction and was completed on (mo/day/year) **02/28/2014** and this record is true to the best of my knowledge and belief. Kansas Water Well Contractor's License No. **647** This Water Well Record was completed on (mo/day/year) **03/01/2014** under the business name of **MEL'S PUMP & PLUMBING INC** by (signature) **Melvin M Anderson**

INSTRUCTIONS: Use typewriter or ball point pen. Please press firmly and print clearly. Please fill in blanks, underline or circle the correct answers. Send top three copies to Kansas Department of Health and Environment, Bureau of Water, Geology Section, 1000 SW Jackson St., Ste. 420, Topeka, Kansas 66612-1367. Telephone: 785/296-5522. Send one to Water Well Owner and retain one for your records.