
WATER WELL PLUGGING R		7 <b>C 5D</b> VSA 91	a-1212 ID NO.	MW-2D	
1 LOCATION OF WATER WELL:	Fraction	Section Number	Township Number	Range Number	
County: Clay	NW 1/4 NW 1/4 NE 1/4 SW	4 8	T 8 S	3 ✓E □W	
Street/Rural Address of Well Location; if unknown, distance & direction from nearest town or intersection: If at owner's address, check here $\Box$ S $B^{th}$ St and Mc Brathney St. Global Positioning Systems (GPS) information: Latitude: 39.37102 (in decimal degrees) Longitude: -97, 12141 (in decimal degrees)					
check here S & St. and McBrathney St. Longitude: <u>-97, 12141</u> (in decimal degrees Elevation:					
Clay Center	-	Horizontal Datum:	✔ WGS84,	NAD83, 🗌 NAD27	
Cormin otrek					
2 WATER WELL OWNER: KDHE RR#, St. Address, Box #: 1000 SW Jackson St.; Ste. 410 ☐ GPS unit (Make/Model: Garmin etter Digital Map/Photo, ☐ Topographic Map, ☐ Land Survey					
			□ < 3 m, 3-5 m, 5-15 m, □ > 15 m		
3 MARK WELL'S LOCATION 4 DEPTH OF WELL 58 ft.					
WITH AN "X" IN SECTION BOX:					
N	WELL WAS USED AS:				
NW NE Domestic Dublic Water Supply Dewatering					
Irrigation Oil Field Water Supply Monitoring					
W E Feedlot Domestic (Lawn & Garden) Injection Well Air Conditioning Other					
SW SE Industrial Air Conditioning Other					
	Was a chemical/bacteriological sample submitted to Department? Yes No				
5 TYPE OF BLANK CASING USED:					
Steel RMP (SR) Wrought Fiberglass Other (Specify below)					
Steel       RMP (SR)       Wrought       Fiberglass       Other (Specify below)         PVC       ABS       Asbestos-Cement       Concrete Tile					
Blank casing diameter _ 1_ in. Was casing pulled? Yes 🗹 No 🗌 If yes, how much all					
Casing height above or below land surface <u>-6</u> in.					
6 GROUT PLUG MATERIAL: Neat cement Cement grout Bentonite Other Top Soil					
Grout Plug Intervals: From $0$ ft. to $3$ ft., From $3$ ft. to $58$ ft., From $_{}$ ft. to $_{}$ ft. to $_{}$ ft.					
What is the nearest source of possible contamination:					
Septic tank       Seepage pit       Fuel storage       Other (specify below)         Sewer lines       Pit privy       Fertilizer storage       Other (specify below)					
Watertight sewer lines     Sewage lagoon     Insecticide storage					
Lateral lines       Feedyard       Abandoned water well       Direction from well?         Cess pool       Livestock pens       Oil well/Gas well       How many feet?					
	GING MATERIALS	FROM TO	PLUGGING	MATERIALS	
0 3 Top Soil 3 58 Bentonite					
3 58 Bentonite					
			<u> </u>		
7 CONTRACTOR'S OR LANDOWNER'S CERTIFICATION: This water well was plugged under my jurisdiction and was completed on (mo/day/year) 5/31/2019 and this record is true to the best of my knowledge and belief. Kansas Water					
Well Contractor's License No. 710 . This Water Well Record was completed on (pro/day/year) 6/26/2019 under the					
business name of Below Ground Surface, Inc. by (signature) Aug K Herri					
Send one white copy to Kansas Department of Health & Environment, Geology Section, 1000 SW Jackson Street, Ste. 420, Topeka, KS					
66612-1367. Send one copy to WATER WELL OWNER and retain one for your records. Visit us at http://www.kdheks.gov/waterwell/index.html Telephone 785-296-5524.					

KSA82a-1212

**Revised 1/20/2015** 

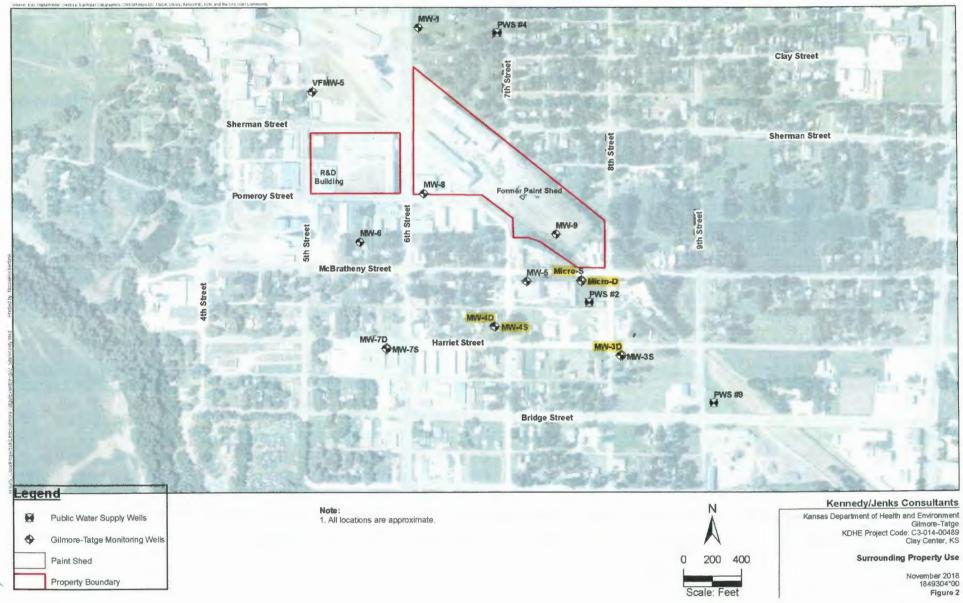

58-78-23

, lay

Figure 2