

Replacement Well

WATER WELL RECORD Form WWC-5


Division of Water Resources App. No.

Well ID

Original Record Correction Change in Well Use

1 LOCATION OF WATER WELL: County: CLAY Fraction: SW 1/4 Sec 13 Township Number: T 8 R 3 Range Number: R 3

2 WELL OWNER: Name: Nelson Poulter First: Address: 8530 E. 24 July City: Manhattan State: KS Zip: 66502 Street or Rural Address where well is located: From Clay Center 6.3 miles East on 24 July to Quail Rd then 6.0 miles to 1 mile East of 701 19th Rd - 6.9 miles South to East

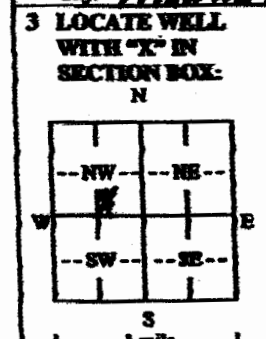

4 DEPTH OF COMPLETED WELL: 160 ft. Depth(s) Groundwater Encountered: 1) 112 ft. 2) 110 ft. 3) 107.5 ft. Well's Static Water Level: 110 ft. 10/15/2020

5 Latitude: N 39° 21' 53.3" Longitude: W 097° 02' 22.2" Horizontal Datum: WGS 84 Source for Latitude/Longitude: GPS (unit make/model: GARMIN E-Trex 70) (WAAS enabled? Yes) Land Survey Topographic Map Online Mapper

6 Elevation: 1315 ft. Ground Level TOC Source: Land Survey GPS Topographic Map Other

- 7 WELL WATER TO BE USED AS: 1. Domestic: Household, Lawn & Garden, Livestock, Irrigation, Feedlot, Industrial. 2. Public Water Supply, Dewatering, Aquifer Recharge, Monitoring, Environmental Remediation, Air Sparge, Soil Vapor Extraction, Recovery, Injection, Oil Field Water Supply, Test Hole, Geothermal.

Was a chemical/bacteriological sample submitted to KDHE? No Water well disinfected? No

8 TYPE OF CASING USED: PVC CASING JOINTS: Glued Casing diameter: 5 in to 1.40 ft. Casing height above land surface: 36 in. Weight: 5.4 lbs/ft.

TYPE OF SCREEN OR PERFORATION MATERIAL: PVC SCREEN OR PERFORATION OPENINGS ARE: Mill Slot SCREEN-PERFORATED INTERVALS: From 140 ft to 160 ft. GRAVEL PACK INTERVALS: From 140 ft to 160 ft.

9 GROUT MATERIAL: Cement grout Grout intervals: From 5 ft to 25 ft. Nearest source of possible contamination: None Close

Table with columns: FROM, TO, LITHOLOGIC LOG, FROM, TO, LITHO. LOG (cont.) or PLUGGING INTERVALS. Rows show soil and rock layers from 0 to 110 ft depth.

11 CONTRACTOR'S OR LANDOWNER'S CERTIFICATION: This water well was constructed, reconstructed, or plugged under my jurisdiction and was completed on (mo-day-year) 10/15/2020 and this record is true to the best of my knowledge and belief.