


1 LOCATION OF WATER WELL: Fraction **NE NE 1/4 SE4** Section Number **7** Township Number **T 8 S** Range Number **R 3 E/W**  
 County: **Clay**

Distance and direction from nearest town or city street address of well if located within city?  
**In alley between Sherman & Pomeroy, east side of 4th, Clay Center, Kansas**

2 WATER WELL OWNER: **Valley Fertilizer**  
 RR#, St. Address, Box #: **118 W. Court Street** Board of Agriculture, Division of Water Resources  
 City, State, ZIP Code: **Beloit, Ks.** Application Number:

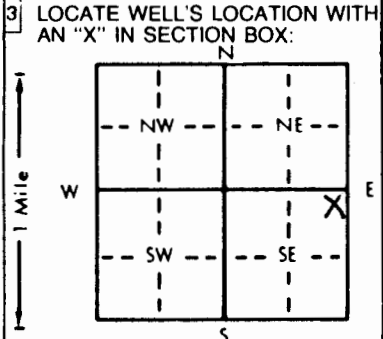

4 DEPTH OF COMPLETED WELL: **67** ft. ELEVATION: **NA**  
 Depth(s) Groundwater Encountered 1. **27** ft. 2. ft. 3. ft.  
 WELL'S STATIC WATER LEVEL ft. below land surface measured on mo/day/yr  
 Pump test data: Well water was ft. after hours pumping gpm  
 Est. Yield gpm: Well water was ft. after hours pumping gpm  
 Bore Hole Diameter: **.8** in. to **.67** ft., and in. to ft.  
 WELL WATER TO BE USED AS: 5 Public water supply 8 Air conditioning 11 Injection well  
 1 Domestic 3 Feedlot 6 Oil field water supply 9 Dewatering 12 Other (Specify below)  
 2 Irrigation 4 Industrial 7 Lawn and garden only **10** Monitoring well  
 Was a chemical/bacteriological sample submitted to Department? Yes No **X**; If yes, mo/day/yr sample was submitted  
 Water Well Disinfected? Yes No **X**

5 TYPE OF BLANK CASING USED: 5 Wrought iron 8 Concrete tile CASING JOINTS: Glued Clamped  
 1 Steel 3 RMP (SR) 6 Asbestos-Cement 9 Other (specify below) Welded  
**2 PVC** 4 ABS 7 Fiberglass Threaded **X**  
 Blank casing diameter **2** in. to **22** ft., Dia in. to ft., Dia in. to ft.  
 Casing height above land surface **0** in., weight lbs./ft. Wall thickness or gauge No. **sch. 40**  
 TYPE OF SCREEN OR PERFORATION MATERIAL: **PVC** 10 Asbestos-cement  
 1 Steel 3 Stainless steel 5 Fiberglass 8 RMP (SR) 11 Other (specify)  
 2 Brass 4 Galvanized steel 6 Concrete tile 9 ABS 12 None used (open hole)  
 SCREEN OR PERFORATION OPENINGS ARE: 5 Gauzed wrapped 8 Saw cut 11 None (open hole)  
 1 Continuous slot **3 Mill slot .010** 6 Wire wrapped 9 Drilled holes  
 2 Louvered shutter 4 Key punched 7 Torch cut 10 Other (specify)

6 GROUT MATERIAL: 1 Neat cement 2 Cement grout 3 Bentonite 4 Other  
 Grout Intervals: From **21** ft. to **19(ben)** ft., From **19** ft. to **0(cem)** ft., From ft. to ft.  
 What is the nearest source of possible contamination:  
 1 Septic tank 4 Lateral lines 7 Pit privy 10 Livestock pens 14 Abandoned water well  
 2 Sewer lines 5 Cess pool 8 Sewage lagoon 11 Fuel storage 15 Oil well/Gas well  
 3 Watertight sewer lines 6 Seepage pit 9 Feedyard 12 Fertilizer storage **16 Other (specify below)**  
 13 Insecticide storage **unknown**  
 Direction from well? **unknown** How many feet? **unknown**

FROM	TO	LITHOLOGIC LOG	FROM	TO	PLUGGING INTERVALS
0	5'	topsoil			
5'	15'	clay, dark brown, silty, sandy, soft			
15	15.25	clay, dark brown to tan, silty, soft			
15.25	23	clay, dark brown, silty, plastic, wet			
23	28	sand, white, fine grained with few medium to coarse grains, wet			
28	28.08	clay, dark, sandy			
28.08	30	sand, light brown, fine to medium grained w/occasional coarse grains & gravel, well rounded, yellow stains			
30	50	sand, brown, medium to coarse grained with gravel			
50	67	sand, brown to red brown, coarse & gravel, interlayered with red-green clay			
67	TD	Winfield limestone			

7 CONTRACTOR'S OR LANDOWNER'S CERTIFICATION: This water well was **(1) constructed, (2) reconstructed,** or (3) plugged under my jurisdiction and was completed on (mo/day/year) **12-21-93** and this record is true to the best of my knowledge and belief. Kansas Water Well Contractor's License No. **527** This Water Well Record was completed on (mo/day/yr) **01-29-94** under the business name of **GeoCore Services, Inc.** by (signature)

INSTRUCTIONS: Use typewriter or ball point pen. PLEASE PRESS FIRMLY and PRINT clearly. Please fill in blanks, underline or circle the correct answers. Send top three copies to Kansas Department of Health and Environment, Bureau of Water, Topeka, Kansas 66620-0001. Telephone: 913-296-5545. Send one to WATER WELL OWNER and retain one for your records.

OFFICE USE ONLY