


1 LOCATION OF WATER WELL: Fraction **NE 1/4 NE 1/4 SE 1/4** Section Number **8** Township Number **T 8 S** Range Number **R 3 E/W**
 County: **Clay**

Distance and direction from nearest town or city street address of well if located within city?
300' East of 3rd, 400' South of Railroad track in City Park, Clay Center, Kansas

2 WATER WELL OWNER: **Valley Fertilizer**
 RR#, St. Address, Box # : **118 W. Court Street**
 City, State, ZIP Code : **Beloit, Ks.**
 Board of Agriculture, Division of Water Resources
 Application Number:

3 LOCATE WELL'S LOCATION WITH AN "X" IN SECTION BOX:

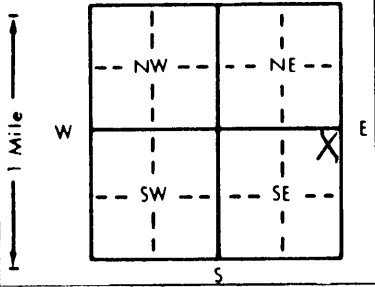

4 DEPTH OF COMPLETED WELL: **67** ft. ELEVATION: **NA**
 Depth(s) Groundwater Encountered 1. **27** ft. 2. ft. 3. ft.
 WELL'S STATIC WATER LEVEL ft. below land surface measured on mo/day/yr
 Pump test data: Well water was ft. after hours pumping gpm
 Est. Yield gpm: Well water was ft. after hours pumping gpm
 Bore Hole Diameter: **8** in. to **67** ft., and in. to ft.
 WELL WATER TO BE USED AS:
 5 Public water supply 8 Air conditioning 11 Injection well
 1 Domestic 3 Feedlot 6 Oil field water supply 9 Dewatering 12 Other (Specify below)
 2 Irrigation 4 Industrial 7 Lawn and garden only **10** Monitoring well
 Was a chemical/bacteriological sample submitted to Department? Yes No **X**; If yes, mo/day/yr sample was submitted
 Water Well Disinfected? Yes No **X**

5 TYPE OF BLANK CASING USED:
 1 Steel 3 RMP (SR) 5 Wrought iron 8 Concrete tile CASING JOINTS: Glued Clamped
2 PVC 4 ABS 6 Asbestos-Cement 9 Other (specify below) Welded
 7 Fiberglass Threaded **X**

Blank casing diameter **2** in. to **22** ft., Dia. in. to ft., Dia. in. to ft.
 Casing height above land surface **0** in., weight lbs./ft. Wall thickness or gauge No. **sch. 40**

TYPE OF SCREEN OR PERFORATION MATERIAL:
 1 Steel 3 Stainless steel 5 Fiberglass **7 PVC** 10 Asbestos-cement
 2 Brass 4 Galvanized steel 6 Concrete tile 9 ABS 11 Other (specify)
 12 None used (open hole)

SCREEN OR PERFORATION OPENINGS ARE:
 1 Continuous slot **3 Mill slot** .010 5 Gauzed wrapped 8 Saw cut 11 None (open hole)
 2 Louvered shutter 4 Key punched 6 Wire wrapped 9 Drilled holes
 7 Torch cut 10 Other (specify)

SCREEN-PERFORATED INTERVALS: From **67** ft. to **22** ft., From ft. to ft.
 From ft. to ft., From ft. to ft.
 GRAVEL PACK INTERVALS: From **67** ft. to **21** ft., From ft. to ft.
 From ft. to ft., From ft. to ft.

6 GROUT MATERIAL: 1 Neat cement 2 Cement grout 3 Bentonite 4 Other
 Grout Intervals: From **21** ft. to **19(ben)** ft., From **22** ft. to **0(cem)** ft., From ft. to ft.

What is the nearest source of possible contamination:
 1 Septic tank 4 Lateral lines 7 Pit privy 10 Livestock pens 14 Abandoned water well
 2 Sewer lines 5 Cess pool 8 Sewage lagoon 11 Fuel storage 15 Oil well/Gas well
 3 Watertight sewer lines 6 Seepage pit 9 Feedyard 12 Fertilizer storage **16** Other (specify below)
 Direction from well? **unknown** How many feet? **unknown**

FROM	TO	LITHOLOGIC LOG	FROM	TO	PLUGGING INTERVALS
0	5'	topsoil			
5'	10'	clay, olive gray, silty, plastic, soft			
10	20	clay, dark brown, silty & sandy, medium plastic, moist			
20	25	sand, tan to white, fine grained, moist			
25	25.03	clay, dark gray, silty, moist			
25.03	30	sand, white to light brown, medium to coarse grained with gravel			
30	33	sand, brown, medium to coarse grained, w/gravel, well rounded			
33	35	sand, light brown, coarse grains & gravel, yellow stains			
35	50	sand, brown, coarse grains & gravel			
50	67	sand, red brown, coarse grains & gravel			
67	TD	Winfield limestone			
MW5-flush mount cover					

7 CONTRACTOR'S OR LANDOWNER'S CERTIFICATION: This water well was **1** constructed, (2) reconstructed, or (3) plugged under my jurisdiction and was completed on (mo/day/year) **12-21-93** and this record is true to the best of my knowledge and belief. Kansas Water Well Contractor's License No. **527**. This Water Well Record was completed on (mo/day/yr) **01-29-94** under the business name of **GeoCore Services, Inc.** by (signature) **Dale Kuhl**

OFFICE USE ONLY

1

2

EW

SEC.

74

74

74