USE TYPEWRITER OR BALL POINT PEN-PRESS FIRMLY, PRINT CLEARLY.

WATER WELL RECORD
KSA 82a-1201-1215

Kansas Department of Health and Environment-Division of Environment
(Water well Contractors)
Topeka, Kansas 66620

Lot 32 Morgans Second Division

1. Location of well:	County	Fraction	Section number	Township number	Range number
	Clay	SE 1/4 SW 1/4 SW 1/4	8	T 8 S	R 3 (E) W

2. Distance and direction from nearest town or city: in Clay Center
Street address of well location if in city:

3. Owner of well: Lawrence Cameron
R.R. or street: 225 Frederick
City, state, zip code: Clay Center, Ks 67432

4. Locate with "X" in section below:

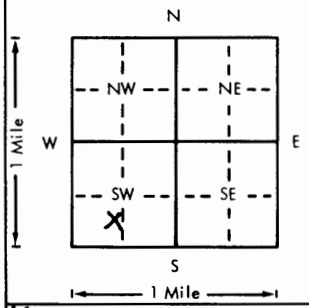

Sketch map:

6. Bore hole dia. 8 in. X Completion date 10-4-78
Well depth 60 ft.

7. __ Cable tool X Rotary __ Driven __ Dug
__ Hollow rod __ Jetted __ Bored __ Reverse rotary

8. Use: X Domestic __ Public supply __ Industry
__ Irrigation __ Air conditioning __ Stock
__ Lawn __ Oil field water __ Other

9. Casing: Material PVC Height: Above ~~or below~~
Threaded ___ Welded ___ Surface 12 in.
RMP ___ PVC X Weight 3 lbs./ft.
Dia. 5 in. to 60 ft. depth Wall Thickness: inches or
Dia. ___ in. to ___ ft. depth ~~gage No.~~ .258

X5. Type and color of material

	From	To
top soil + clay	0	18
sand	18	29
gravel	29	60

(Use a second sheet if needed)

10. Screen: Manufacturer's name Pumper
Type PVC Dia. 5
Slot/~~gauze~~ 1/16" Length 10
Set between 50 ft. and 60 ft.
___ ft. and ___ ft.
Gravel pack? YES Size range of material 1/8-1/4

11. Static water level: mo./day/yr.
27 ft. below land surface Date 10-4-78

12. Pumping level below land surfaces:
35 ft. after 1 hrs. pumping 20 g.p.m.
___ ft. after ___ hrs. pumping ___ g.p.m.
Estimated maximum yield 50 g.p.m.

13. Water sample submitted: mo./day/yr.
__ Yes X No Date

14. Well head completion:
__ Pitless adapter 12 Inches above grade

15. Well grouted? YES
With: X Neat cement __ Bentonite __ Concrete
Depth: From 0 ft. to 10 ft.

X16. Nearest source of possible contamination: NONE
ft. 200 Direction S Type city sewer
Well disinfected upon completion? X Yes __ No

17. Pump: X Not installed
Manufacturer's name
Model number HP Volts
Length of drop pipe ft. capacity g.p.m.
Type:
__ Submersible __ Turbine
__ Jet __ Reciprocating
__ Centrifugal __ Other

18. Elevation:

Topography:
__ Hill
__ Slope
__ Upland
X Valley

19. Remarks: notified 1-3-79
somebody else would install pump

20. Water well contractor's certification:
This well was drilled under my jurisdiction and this report is true to the best of my knowledge and belief.
Cox-Beswick 361
Business name License No.
Address Clifton, Kansas
Signed Francis Cox Date 10-28-78
Authorized representative

T 8 — R 3 (E) W — Sec 8 — 1/4 SE 1/4 SW 1/4

Forward the white, blue and pink copies to the Department of Health and Environment

Form WWC-5

MI-1023