


1 LOCATION OF WATER WELL: Fraction NE 1/4 NW 1/4 NW 1/4 Section Number 8 Township Number T 8 S Range Number R 3 E/W
 County: Clay
 Distance and direction from nearest town or city street address of well if located within city?
813 6th Street

2 WATER WELL OWNER: Onette E. Shannon
 RR#, St. Address, Box #: 813 6th Board of Agriculture, Division of Water Resources
 City, State, ZIP Code: Clay Center KS 67432 Application Number:

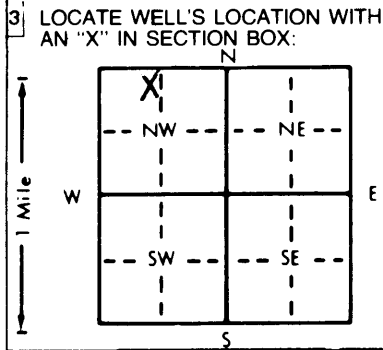

4 DEPTH OF COMPLETED WELL: 38 ft. ELEVATION:
 Depth(s) Groundwater Encountered 1. 31 ft. 2. ft. 3. ft.
 WELL'S STATIC WATER LEVEL 30.90 ft. below land surface measured on mo/day/yr 3-3-93
 Pump test data: Well water was _____ ft. after _____ hours pumping _____ gpm
 Est. Yield _____ gpm; Well water was _____ ft. after _____ hours pumping _____ gpm
 Bore Hole Diameter: 8 in. to _____ ft. and _____ in. to _____ ft.
 WELL WATER TO BE USED AS:
 5 Public water supply 8 Air conditioning 11 Injection well
 1 Domestic 3 Feedlot 6 Oil field water supply 9 Dewatering 12 Other (Specify below)
 2 Irrigation 4 Industrial 7 Lawn and garden only 10 Monitoring well
 Was a chemical/bacteriological sample submitted to Department? Yes _____ No X If yes, mo/day/yr sample was sub-
 mitted Water Well Disinfected? Yes _____ No X

5 TYPE OF BLANK CASING USED:
 1 Steel 3 RMP (SR) 5 Wrought iron 8 Concrete tile CASING JOINTS: Glued _____ Clamped _____
2 PVC 4 ABS 6 Asbestos-Cement 9 Other (specify below) Welded _____
 7 Fiberglass Threaded Flush
 Blank casing diameter 2 in. to _____ ft. Dia _____ in. to _____ ft. Dia _____ in. to _____ ft.
 Casing height above land surface Flush in., weight 703 lbs./ft. Wall thickness or gauge No. 154
 TYPE OF SCREEN OR PERFORATION MATERIAL:
 1 Steel 3 Stainless steel 5 Fiberglass 8 RMP (SR) 10 Asbestos-cement
 2 Brass 4 Galvanized steel 6 Concrete tile 9 ABS 12 None used (open hole)
 SCREEN OR PERFORATION OPENINGS ARE:
 1 Continuous slot 3 Mill slot 5 Gauzed wrapped 8 Saw cut 11 None (open hole)
 2 Louvered shutter 4 Key punched 6 Wire wrapped 9 Drilled holes
 7 Torch cut 10 Other (specify) _____
 SCREEN-PERFORATED INTERVALS: From 23 ft. to 38 ft. From _____ ft. to _____ ft.
 From _____ ft. to _____ ft. From _____ ft. to _____ ft.
 GRAVEL PACK INTERVALS: From 22 ft. to 38 ft. From _____ ft. to _____ ft.
 From _____ ft. to _____ ft. From _____ ft. to _____ ft.

6 GROUT MATERIAL: 1 Neat cement 2 Cement grout 3 Bentonite 4 Other _____
 Grout Intervals: From 22 ft. to 1 ft. From _____ ft. to _____ ft. From _____ ft. to _____ ft.
 What is the nearest source of possible contamination:
 1 Septic tank 4 Lateral lines 7 Pit privy 11 Fuel storage 14 Abandoned water well
 2 Sewer lines 5 Cess pool 8 Sewage lagoon 12 Fertilizer storage 15 Oil well/Gas well
 3 Watertight sewer lines 6 Seepage pit 9 Feedyard 13 Insecticide storage 16 Other (specify below)
 Direction from well? SE How many feet? 50

FROM	TO	LITHOLOGIC LOG	FROM	TO	PLUGGING INTERVALS
0.0	0.5	Concrete			
0.5	3.5	fill, silt & lean clay			
3.5	4.5	Sand, silty			
4.5	7.0	Lean Clay			
7.0	11.5	Fat Clay			
11.5	13.5	Silt Lean Clay			
13.5	18.5	Sand, Clayey			
18.5	28.5	Silt			
28.5	38	Sand, well graded			

Flush mount waiver granted 12-10-92 for
 Shannon's Conoco Services, KDHE 0514535
 by Don Taylor

7 CONTRACTOR'S OR LANDOWNER'S CERTIFICATION: This water well was (1) constructed, (2) reconstructed, or (3) plugged under my jurisdiction and was completed on (mo/day/year) 3-3-93 and this record is true to the best of my knowledge and belief. Kansas Water Well Contractor's License No. 531 This Water Well Record was completed on (mo/day/yr) 3-23-93 under the business name of GSI by (signature) Allison Iverson