


1 LOCATION OF WATER WELL: Fraction NW 1/4 NW 1/4 Section Number 8 Township Number T 8 S Range Number R 3 E  
 County: Clay

Distance and direction from nearest town or city street address of well if located within city?  
120' south of intersection of Dexter & 4th Street, Clay Center, Ks.

2 WATER WELL OWNER: Valley Fertilizer  
 RR#, St. Address, Box #: 118 W. Court Street Board of Agriculture, Division of Water Resources  
 City, State, ZIP Code: Beloit, Ks. Application Number:

3 LOCATE WELL'S LOCATION WITH AN "X" IN SECTION BOX:

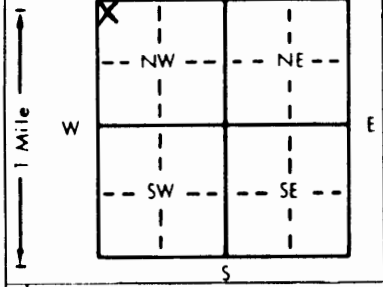

4 DEPTH OF COMPLETED WELL: 67 ft. ELEVATION: NA  
 Depth(s) Groundwater Encountered 1. 27 ft. 2. ft. 3. ft.  
 WELL'S STATIC WATER LEVEL 27 ft. below land surface measured on mo/day/yr 05-12-93  
 Pump test data: Well water was ft. after hours pumping gpm  
 Est. Yield gpm: Well water was ft. after hours pumping gpm  
 Bore Hole Diameter 7.5/8 in. to 67 ft., and in. to ft.  
 WELL WATER TO BE USED AS: 5 Public water supply 8 Air conditioning 11 Injection well  
 1 Domestic 3 Feedlot 6 Oil field water supply 9 Dewatering 12 Other (Specify below)  
 2 Irrigation 4 Industrial 7 Lawn and garden only 10 Monitoring well  
 Was a chemical/bacteriological sample submitted to Department? Yes No x; If yes, mo/day/yr sample was submitted  
 Water Well Disinfected? Yes No x

5 TYPE OF BLANK CASING USED: 5 Wrought iron 8 Concrete tile CASING JOINTS: Glued Clamped  
 1 Steel 3 RMP (SR) 6 Asbestos-Cement 9 Other (specify below) Welded  
2 PVC 4 ABS 7 Fiberglass Threaded x

Blank casing diameter 2 in. to 26 ft., Dia. in. to ft., Dia. in. to ft.  
 Casing height above land surface 0 in., weight lbs./ft. Wall thickness or gauge No. sch. 40

TYPE OF SCREEN OR PERFORATION MATERIAL: 7 PVC 10 Asbestos-cement  
 1 Steel 3 Stainless steel 5 Fiberglass 8 RMP (SR) 11 Other (specify)  
 2 Brass 4 Galvanized steel 6 Concrete tile 9 ABS 12 None used (open hole)

SCREEN OR PERFORATION OPENINGS ARE: 5 Gauzed wrapped 8 Saw cut 11 None (open hole)  
 1 Continuous slot 3 Mill slot 6 Wire wrapped 9 Drilled holes  
 2 Louvered shutter 4 Key punched 7 Torch cut 10 Other (specify)

SCREEN-PERFORATED INTERVALS: From 26 ft. to 67 ft., From ft. to ft.  
 From ft. to ft., From ft. to ft.  
 GRAVEL PACK INTERVALS: From 24 ft. to 67 ft., From ft. to ft.  
 From ft. to ft., From ft. to ft.

6 GROUT MATERIAL: 1 Neat cement 2 Cement grout 3 Bentonite 4 Other  
 Grout Intervals: From 0 ft. to 17 ft., From 17 ft. to 54 ft., From ft. to ft.

What is the nearest source of possible contamination:  
 1 Septic tank 4 Lateral lines 7 Pit privy 10 Livestock pens 14 Abandoned water well  
 2 Sewer lines 5 Cess pool 8 Sewage lagoon 11 Fuel storage 15 Oil well/Gas well  
 3 Watertight sewer lines 6 Seepage pit 9 Feedyard 12 Fertilizer storage 16 Other (specify below)  
 13 Insecticide storage

Direction from well? NW How many feet? 1320

FROM	TO	LITHOLOGIC LOG	FROM	TO	PLUGGING INTERVALS
0	7.5	clay, black, organic			
7.5	9.5	clay, brown, plastic			
9.5	13	clay, dark brown, silty			
13	18	silt, tan			
18	20.5	silt, tan, very sandy			
20.5	23	silt, brown, clayey			
23	25.5	silt, tan, sandy			
25.5	26.5	sand, tan, fine grained, silty			
26.5	28	sand, tan, fine to medium grained			
28	67	sand, tan-red, medium to course grained with fine gravel			MW11-flush mount cover
67		limestone			

7 CONTRACTOR'S OR LANDOWNER'S CERTIFICATION: This water well was (1) constructed, (2) reconstructed, or (3) plugged under my jurisdiction and was completed on (mo/day/year) 05-12-93 and this record is true to the best of my knowledge and belief. Kansas Water Well Contractor's License No. 527. This Water Well Record was completed on (mo/day/yr) 12-21-93 under the business name of GeoCore Services, Inc. by (signature) Dave Kohl