


1 LOCATION OF WATER WELL: County: Clay Fraction NE 1/4 NW 1/4 SW 1/4 Section Number 8 Township Number 8 S Range Number 3 E/W

Distance and direction from nearest town or city street address of well if located within city? 150 East of Intersection of 5th and McBrathney Clay Center

2 WATER WELL OWNER: Valley Fertilizer RR#: St. Address, Box #: 118 West Court Street City, State, ZIP Code: Beloit, Ks Board of Agriculture, Division of Water Resources Application Number:

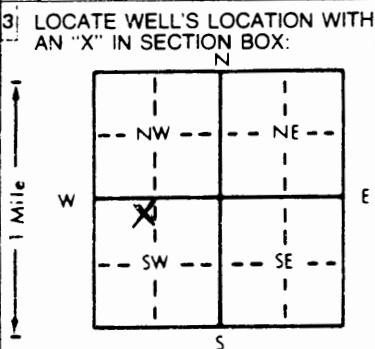

3 LOCATE WELL'S LOCATION WITH AN 'X' IN SECTION BOX: 4 DEPTH OF COMPLETED WELL: 60 ft. ELEVATION: Depth(s) Groundwater Encountered 1. 2. 3. WELL'S STATIC WATER LEVEL 23 ft. below land surface measured on mo/day/yr Pump test data: Well water was ... gpm Est. Yield ... gpm Well water was ... gpm Bore Hole Diameter 8 in. to 60 in. and ... in. to ... ft. WELL WATER TO BE USED AS: 5 Public water supply 8 Air conditioning 11 Injection well 1 Domestic 3 Feedlot 6 Oil field water supply 9 Dewatering 12 Other (Specify below) 2 Irrigation 4 Industrial 7 Lawn and garden only 10 Monitoring well Was a chemical/bacteriological sample submitted to Department? Yes... No... If yes, mo/day/yr sample was submitted Water Well Disinfected? Yes No X

5 TYPE OF BLANK CASING USED: 1 Steel 3 RMP (SR) 5 Wrought iron 8 Concrete tile CASING JOINTS: Glued Clamped 2 PVC 4 ABS 6 Asbestos-Cement 9 Other (specify below) Welded Threaded X Blank casing diameter 2 in. to 25 ft. Dia. in. to ... ft. Dia. in. to ... ft. Casing height above land surface 0 in., weight ... lbs./ft. Wall thickness or gauge No. Sch. 40 TYPE OF SCREEN OR PERFORATION MATERIAL: 1 Steel 3 Stainless steel 5 Fiberglass 7 PVC 10 Asbestos-cement 2 Brass 4 Galvanized steel 6 Concrete tile 8 RMP (SR) 11 Other (specify) 12 None used (open hole) SCREEN OR PERFORATION OPENINGS ARE: 1 Continuous slot 3 Mill slot 5 Gauzed wrapped 8 Saw cut 11 None (open hole) 2 Louvered shutter 4 Key punched 6 Wire wrapped 9 Drilled holes 10 Other (specify) SCREEN-PERFORATED INTERVALS: From 25 ft. to 60 ft. From ... ft. to ... ft. GRAVEL PACK INTERVALS: From 23 ft. to 60 ft. From ... ft. to ... ft.

6 GROUT MATERIAL: 1 Neat cement 2 Cement grout 3 Bentonite 4 Other Grout Intervals: From 0 ft. to 21 ft. From 21 ft. to 23 ft. From ... ft. to ... ft. What is the nearest source of possible contamination: 1 Septic tank 4 Lateral lines 7 Pit privy 10 Livestock pens 14 Abandoned water well 2 Sewer lines 5 Cess pool 8 Sewage lagoon 11 Fuel storage 15 Oil well/Gas well 3 Watertight sewer lines 6 Seepage pit 9 Feedyard 12 Fertilizer storage 16 Other (specify below) UNIC 13 Insecticide storage How many feet?

Direction from well? FROM TO LITHOLOGIC LOG FROM TO PLUGGING INTERVALS

0	1	Clay, dark gray, organic			
1	13	Silt, tan			
13	23	Silt, tan, slightly clayey			
23	30	Sand, tan, fine to medium grained			
30	60	Sand, coarse grained to fine gravel			
60	60.5	Limestone, auger refusal (Winfield Limestone)			

MW18- Flushmount

7 CONTRACTOR'S OR LANDOWNER'S CERTIFICATION: This water well was (1) constructed, (2) reconstructed, or (3) plugged under my jurisdiction and was completed on (mo/day/year) 12-20-94 and this record is true to the best of my knowledge and belief. Kansas Water Well Contractor's License No. 527 This Water Well Record was completed on (mo/day/yr) 1-24-95 under the business name of GeoCore Services, Ks. by (signature) Dale Roll

INSTRUCTIONS: Use typewriter or ball point pen. PLEASE PRESS FIRMLY and PRINT clearly. Please fill in blanks, underline or circle the correct answers. Send top three copies to Kansas Department of Health and Environment, Bureau of Water, Topeka, Kansas 66620-0001. Telephone: 913-296-5545. Send one to WATER WELL OWNER and retain one for your records.