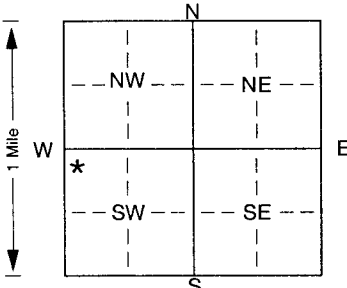


1 LOCATION OF WATER WELL: Fraction NW 1/4 NW 1/4 SW 1/4 Section Number 36 Township Number T 8 S Range Number R 4 (EW)  
 County: Riley

Distance and direction from nearest town or city street address of well if located within city?  
6 West of Riley at Bala

2 WATER WELL OWNER: Richard Pride  
 RR#, St. Address, Box # : 7714 Jenkins Rd. Board of Agriculture, Division of Water Resources  
 City, State, ZIP Code : Riley, KS 66531 Application Number:

3 LOCATE WELL'S LOCATION WITH AN "X" IN SECTION BOX:  4 DEPTH OF COMPLETED WELL: 102 ft. ELEVATION: ..... ft.  
 Depth(s) Groundwater Encountered 1. .... ft. 2. .... ft. 3. .... ft.  
 WELL'S STATIC WATER LEVEL: 55' ft. below land surface measured on mo/day/yr 4/23/02  
 Pump test data: Well water was ..... ft. after ..... hours pumping ..... gpm  
 Est. Yield 10-15 gpm: Well water was ..... ft. after ..... hours pumping ..... gpm  
 Bore Hole Diameter: 8 1/2 in. to 102 ft., and ..... in. to ..... ft.  
 WELL WATER TO BE USED AS: 5 Public water supply 8 Air conditioning 11 Injection well  
1 Domestic 3 Feedlot 6 Oil field water supply 9 Dewatering 12 Other (Specify below)  
2 Irrigation 4 Industrial 7 Domestic (lawn & garden) 10 Monitoring well  
 Was a chemical/bacteriological sample submitted to Department? Yes. .... No. \*; If yes, mo/day/yr sample was submitted  
 Water Well Disinfected? Yes \* No

5 TYPE OF BLANK CASING USED: 5 Wrought iron 8 Concrete tile CASING JOINTS: Glued. \* Clamped. ....  
 1 Steel 3 RMP (SR) 6 Asbestos-Cement 9 Other (specify below) Welded .....  
2 PVC 4 ABS 7 Fiberglass ..... Threaded. ....  
 Blank casing diameter ..... 5 in. to 82 ft., Dia ..... in. to ..... ft., Dia ..... in. to ..... ft.  
 Casing height above land surface: 18 in., weight 200 lbs./ft. Wall thickness or gauge No. .265  
 TYPE OF SCREEN OR PERFORATION MATERIAL: 7 PVC 10 Asbestos-cement  
 1 Steel 3 Stainless steel 5 Fiberglass 8 RMP (SR) 11 Other (specify) .....  
 2 Brass 4 Galvanized steel 6 Concrete tile 9 ABS 12 None used (open hole)  
 SCREEN OR PERFORATION OPENINGS ARE: 5 Gauzed wrapped 8 Saw cut 11 None (open hole)  
1 Continuous slot 3 Mill slot 6 Wire wrapped 9 Drilled holes  
 2 Louvered shutter 4 Key punched 7 Torch cut 10 Other (specify) ..... ft.  
 SCREEN-PERFORATED INTERVALS: From ..... 82 ft. to 102 ft., From ..... ft. to ..... ft.  
 From ..... ft. to ..... ft., From ..... ft. to ..... ft.  
 GRAVEL PACK INTERVALS: From ..... 25 ft. to 102 ft., From ..... ft. to ..... ft.  
 From ..... ft. to ..... ft., From ..... ft. to ..... ft.

6 GROUT MATERIAL: 1 Neat cement 2 Cement grout 3 Bentonite 4 Other .....  
 Grout Intervals: From ..... 5 ft. to 25 ft., From ..... ft. to ..... ft., From ..... ft. to ..... ft.  
 What is the nearest source of possible contamination: 10 Livestock pens 14 Abandoned water well  
 1 Septic tank 4 Lateral lines 7 Pit privy 11 Fuel storage 15 Oil well/Gas well  
 2 Sewer lines 5 Cess pool 8 Sewage lagoon 12 Fertilizer storage 16 Other (specify below)  
 3 Watertight sewer lines 6 Seepage pit 9 Feedyard 13 Insecticide storage .....  
 Direction from well? SE How many feet? 150

FROM	TO	LITHOLOGIC LOG	FROM	TO	PLUGGING INTERVALS
0	4	Topsoil			
4	17	Brown Clay			
17	23	Yellow Shale			
23	25	RED Shale			
25	32	Tan Shale			
32	64	Gray Shale			
64	71	Limestone Layers			
71	82	Gray Shale			
82	94	Limestone Layers			
94	102	Gray Shale			

7 CONTRACTOR'S OR LANDOWNER'S CERTIFICATION: This water well was (1) constructed, (2) reconstructed, or (3) plugged under my jurisdiction and was completed on (mo/day/year) ..... 4/23/02 ..... and this record is true to the best of my knowledge and belief. Kansas Water Well Contractor's Licence No. .... 51.8 ..... This Water Well Record was completed on (mo/day/yr) 4/24/02 ..... under the business name of Blue Valley Drilling by (signature) [Signature]