

1706-72

1 LOCATION OF WATER WELL: County: RILEY Fraction: SE 1/4 SE 1/4 SW 1/4 Section Number: 24 Township Number: T 8 S Range Number: R 4 EAN

Distance and direction from nearest town or city street address of well if located within city?


FROM LEONAROVILLE 3 1/2 WEST, 2 SOUTH, 1/2 WEST

2 WATER WELL OWNER: GREG BELL

RR#, St. Address, Box #: 17070 WELSH RD  
 City, State, ZIP Code: RILEY, KS 66521

Board of Agriculture, Division of Water Resources  
 Application Number: \_\_\_\_\_

3 LOCATE WELL'S LOCATION WITH AN "X" IN SECTION BOX: 4 DEPTH OF COMPLETED WELL: 230 ft. ELEVATION: \_\_\_\_\_

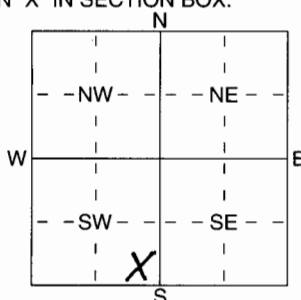

Depth(s) Groundwater Encountered: 1 1 ft. 2 \_\_\_\_\_ ft. 3 \_\_\_\_\_ ft.  
 WELL'S STATIC WATER LEVEL: \_\_\_\_\_ ft. below land surface measured on mo/day/yr  
 Pump test data: Well water was \_\_\_\_\_ ft. after \_\_\_\_\_ hours pumping \_\_\_\_\_ gpm  
 Est. Yield: 12 gpm: Well water was \_\_\_\_\_ ft. after \_\_\_\_\_ hours pumping \_\_\_\_\_ gpm  
 WELL WATER TO BE USED AS:  
 1 Domestic 3 Feedlot 6 Oil field water supply 9 Dewatering 12 Other (Specify below)  
 2 Irrigation 4 Industrial 7 Domestic (lawn & garden) 10 Monitoring well CLOSED LOOP GROUNDWATER

Was a chemical/bacteriological sample submitted to Department? Yes \_\_\_\_\_ No X; If yes, mo/day/yr sample was submitted  
 Water Well Disinfected? Yes X No \_\_\_\_\_

5 TYPE OF BLANK CASING USED:  
 1 Steel 3 RMP (SR) 5 Wrought iron 8 Concrete tile CASING JOINTS: Glued X Clamped \_\_\_\_\_  
 2 PVC 4 ABS 6 Asbestos-Cement 9 Other (specify below) Welded X  
 7 Fiberglass Threaded \_\_\_\_\_  
HURP

Blank casing diameter: 3/4 in. to 230 ft. Dia \_\_\_\_\_ in. to \_\_\_\_\_ ft. Dia \_\_\_\_\_ in. to \_\_\_\_\_ ft.  
 Casing height above land surface: 60 in., weight \_\_\_\_\_ lbs./ft. Wall thickness or gauge No. S&P 11

TYPE OF SCREEN OR PERFORATION MATERIAL:  
 1 Steel 3 Stainless Steel 5 Fiberglass 7 PVC 10 Asbestos-Cement  
 2 Brass 4 Galvanized Steel 6 Concrete tile 8 RMP (SR) 11 Other (Specify) \_\_\_\_\_  
 9 ABS 12 None used (open hole)

SCREEN OR PERFORATION OPENINGS ARE:  
 1 Continuous slot 3 Mill slot 5 Gauzed wrapped 8 Saw cut 11 None (open hole)  
 2 Louvered shutter 4 Key punched 6 Wire wrapped 9 Drilled holes  
 7 Torch cut 10 Other (specify) \_\_\_\_\_

SCREEN-PERFORATED INTERVALS: From \_\_\_\_\_ ft. to \_\_\_\_\_ ft., From \_\_\_\_\_ ft. to \_\_\_\_\_ ft.  
 GRAVEL PACK INTERVALS: From \_\_\_\_\_ ft. to \_\_\_\_\_ ft., From \_\_\_\_\_ ft. to \_\_\_\_\_ ft.

6 GROUT MATERIAL: 1 Neat cement 2 Cement grout 3 Bentonite 4 Other \_\_\_\_\_  
 Grout Intervals: From 5 ft. to 230 ft., From \_\_\_\_\_ ft. to \_\_\_\_\_ ft., From \_\_\_\_\_ ft. to \_\_\_\_\_ ft.

What is the nearest source of possible contamination:  
 1 Septic tank 4 Lateral lines 7 Pit privy 10 Livestock pens 14 Abandoned water well  
 2 Sewer lines 5 Cess pool 8 Sewage lagoon 11 Fuel storage 15 Oil well/Gas well  
 3 Watertight sewer lines 6 Seepage pit 9 Feedyard 12 Fertilizer storage 16 Other (specify below)  
 \_\_\_\_\_ HOUSE  
 Direction from well? EAST How many feet? 17

FROM	TO	LITHOLOGIC LOG	FROM	TO	PLUGGING INTERVALS
0	23	CLAY			<p>RECEIVED                      OCT 01 2004                      BUREAU OF WATER                      1 hole to 230</p>
23	50	SHALE, RED TO BROWN			
50	54	LIMESTONE			
54	63	SHALE, BROWN			
63	65	LIMESTONE			
65	75	SHALE, RED			
75	77	LIMESTONE, H <sub>2</sub> O			
77	124	SHALE, BROWN TO GRAY			
124	130	LIMESTONE			
130	219	SHALE, GRAY, RED TO GRAY			
219	221	LIMESTONE			
221	230	SHALE, BROWN TO GRAY			

7 CONTRACTOR'S OR LANDOWNER'S CERTIFICATION: This ~~well~~ well was (1) constructed, (2) reconstructed, or (3) plugged under my jurisdiction and was completed on (mo/day/year) 7/30/04 and this record is true to the best of my knowledge and belief. Kansas Water Well Contractor's Licence No. 585 This Water Well Record was completed on (mo/day/yr) 9/16/04 under the business name of ASSOCIATED ENVIRONMENTAL INC. by (signature) \_\_\_\_\_