


1 LOCATION OF WATER WELL: County: CLAY Fraction: W 1/4 NE 1/4 NW 1/4 Section Number: 17 Township Number: T 8 S Range Number: R 4 E/W

Distance and direction from nearest town or city street address of well if located within city? From CLAY CENTER GO 7 MILES EAST ON 24 + 1 mile south on County Road 1/4 WEST ON Township Road

2 WATER WELL OWNER: Mr. Roy Baxter
 RR#, St. Address, Box #: RR # 3
 City, State, ZIP Code: CLAY CENTER, MS.
 Board of Agriculture, Division of Water Resources
 Application Number:

3 LOCATE WELL'S LOCATION WITH AN "X" IN SECTION BOX:

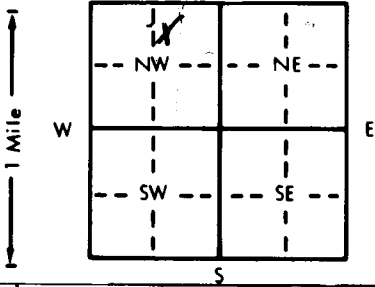

4 DEPTH OF COMPLETED WELL: 120' ft. ELEVATION:

Depth(s) Groundwater Encountered 1. 54 ft. 2. 95 ft. 3. ft.
 WELL'S STATIC WATER LEVEL 50 ft. below land surface measured on mo/day/yr
 Pump test data: Well water was ft. after hours pumping gpm
 Est. Yield 20 gpm: Well water was ft. after hours pumping gpm
 Bore Hole Diameter: 8 in. to 120 ft., and in. to ft.
 WELL WATER TO BE USED AS:
 1 Domestic 3 Feedlot 6 Oil field water supply 9 Dewatering 12 Other (Specify below)
 2 Irrigation 4 Industrial 7 Lawn and garden only 10 Observation well
 Was a chemical/bacteriological sample submitted to Department? Yes.....No.....; If yes, mo/day/yr sample was submitted
 Water Well Disinfected? Yes No

5 TYPE OF BLANK CASING USED:
 1 Steel 3 RMP (SR) 5 Wrought iron 8 Concrete tile CASING JOINTS: Glued Clamped
 2 PVC 4 ABS 6 Asbestos-Cement 9 Other (specify below) Welded Screwed
 7 Fiberglass Threaded

Blank casing diameter 5 in. to 120 ft., Dia. in. to ft., Dia. in. to ft.
 Casing height above land surface 2' in., weight lbs./ft. Wall thickness or gauge No.

TYPE OF SCREEN OR PERFORATION MATERIAL:
 1 Steel 3 Stainless steel 5 Fiberglass 7 PVC 10 Asbestos-cement
 2 Brass 4 Galvanized steel 6 Concrete tile 8 RMP (SR) 11 Other (specify)
 12 None used (open hole)

SCREEN OR PERFORATION OPENINGS ARE:
 1 Continuous slot 3 Mill slot 3/1000 5 Gauzed wrapped 8 Saw cut 11 None (open hole)
 2 Louvered shutter 4 Key punched 6 Wire wrapped 9 Drilled holes
 7 Torch cut 10 Other (specify)

SCREEN-PERFORATED INTERVALS: From 90' ft. to 110' ft., From ft. to ft.
 From ft. to ft., From ft. to ft.
 GRAVEL PACK INTERVALS: From 1.5 ft. to 120' ft., From ft. to ft.
 From ft. to ft., From ft. to ft.

6 GROUT MATERIAL: Neat cement 2 Cement grout 3 Bentonite 4 Other
 Grout Intervals: From 5 ft. to 1.5 ft., From ft. to ft., From ft. to ft.

What is the nearest source of possible contamination: None Close
 1 Septic tank 4 Lateral lines 7 Pit privy 10 Livestock pens 14 Abandoned water well
 2 Sewer lines 5 Cess pool 8 Sewage lagoon 11 Fuel storage 15 Oil well/Gas well
 3 Watertight sewer lines 6 Seepage pit 9 Feedyard 12 Fertilizer storage 16 Other (specify below)
 13 Insecticide storage

Direction from well? How many feet?

FROM	TO	LITHOLOGIC LOG	FROM	TO	LITHOLOGIC LOG
0	9	Brown Clay	95	115	Rock
9	13	Rock	115	120	Shale
13	16	Yellow Clay			
16	35	Brown Clay			
35	48	Rock			
48	54	Green Shale			
54	56	Rock			
56	66	Green Shale			
66	67	Rock			
67	71	Green Shale			
71	74	Brown Shale			
74	76	Rock			
76	86	Brown Shale			
86	92	Rock			
92	95	Brown Shale			

7 CONTRACTOR'S OR LANDOWNER'S CERTIFICATION: This water well was (1) constructed, (2) reconstructed, or (3) plugged under my jurisdiction and was completed on (mo/day/year) 4/17/86 and this record is true to the best of my knowledge and belief, Kansas Water Well Contractor's License No. 451 This Water Well Record was completed on (mo/day/yr) 5/6/86

under the business name of Hildner Well Drilling by (signature) Craig Hildner

INSTRUCTIONS: Use typewriter or ball point pen, PLEASE PRESS FIRMLY and PRINT clearly. Please fill in blanks, underline or circle the correct answers. Send top three copies to Kansas Department of Health and Environment, Division of Environment, Environmental Geology Section, Topeka, KS 66620. Send one to WATER WELL OWNER and retain one for your records.