


1 LOCATION OF WATER WELL: County: Clay Fraction: NE 1/4 NE 1/4 NE 1/4 Section Number: 34 Township Number: 8 S Range Number: 4 E

Distance and direction from nearest town or city street address of well if located within city? From Clay Center 60 10 miles EAST OF CLAY CENTER ON BROUGHTON ROAD

2 WATER WELL OWNER: Ron Chewy
 RR#, St. Address, Box #: 2298 Broughton Rd. Board of Agriculture, Division of Water Resources
 City, State, ZIP Code: Clay Center, Kansas 67432 Application Number:

3 LOCATE WELL'S LOCATION WITH AN "X" IN SECTION BOX:

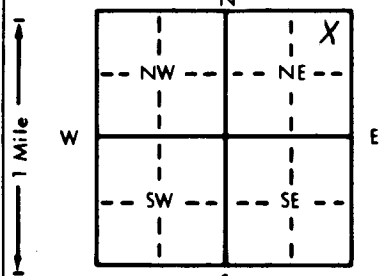

4 DEPTH OF COMPLETED WELL: 100 ft. ELEVATION:

Depth(s) Groundwater Encountered 1. 65 ft. 2. ft. 3. ft.
 WELL'S STATIC WATER LEVEL 50 ft. below land surface measured on mo/day/yr
 Pump test data: Well water was ft. after hours pumping gpm
 Est. Yield 12 gpm Well water was ft. after hours pumping gpm
 Bore Hole Diameter 9 in. to 100 ft., and in. to ft.
 WELL WATER TO BE USED AS:
 Domestic 3 Feedlot 6 Oil field water supply 8 Air conditioning 11 Injection well
 2 Irrigation 4 Industrial 7 Lawn and garden only 9 Dewatering 12 Other (Specify below)
 Was a chemical/bacteriological sample submitted to Department? Yes No; If yes, mo/day/yr sample was submitted
 Water Well Disinfected? Yes No

5 TYPE OF BLANK CASING USED:
 1 Steel 3 RMP (SR) 5 Wrought iron 8 Concrete tile CASING JOINTS: Glued Clamped
 2 PVC 4 ABS 6 Asbestos-Cement 9 Other (specify below) Welded
 Blank casing diameter 5 in. to 80 ft., Dia. in. to ft., Dia. in. to ft.
 Casing height above land surface 1' in., weight Sch 40 lbs./ft. Wall thickness or gauge No. Threaded

TYPE OF SCREEN OR PERFORATION MATERIAL:
 1 Steel 3 Stainless steel 5 Fiberglass 7 PVC 10 Asbestos-cement
 2 Brass 4 Galvanized steel 6 Concrete tile 8 RMP (SR) 11 Other (specify)
 SCREEN OR PERFORATION OPENINGS ARE:
 1 Continuous slot 3 Mill slot 25/10005 5 Gauzed wrapped 8 Saw cut 11 None (open hole)
 2 Louvered shutter 4 Key punched 6 Wire wrapped 9 Drilled holes
 SCREEN-PERFORATED INTERVALS: From 80 ft. to 100 ft., From ft. to ft.
 GRAVEL PACK INTERVALS: From 25 ft. to 100 ft., From ft. to ft.

6 GROUT MATERIAL: 1 Neat cement 2 Cement grout 3 Bentonite 4 Other
 Grout Intervals: From 0 ft. to 25 ft., From ft. to ft., From ft. to ft.

What is the nearest source of possible contamination:
 1 Septic tank 4 Lateral lines 7 Pit privy 10 Livestock pens 14 Abandoned water well
 2 Sewer lines 5 Cess pool 8 Sewage lagoon 11 Fuel storage 15 Oil well/Gas well
 3 Watertight sewer lines 6 Seepage pit 9 Feedyard 12 Fertilizer storage 16 Other (specify below)
 13 Insecticide storage
 Direction from well? EAST How many feet? 100'

FROM	TO	LITHOLOGIC LOG	FROM	TO	PLUGGING INTERVALS
0	1	Top Soil			
1	2	Gravel			
2	25	Brown Shale			
25	28	Limestone			
28	49	Brown Shale			
49	51	Limestone			
51	53	Brown Shale			
53	54	Limestone			
54	59	Brown Shale			
59	63	Limestone			
63	65	Brown Shale			
65	86	Limestone (Water)			
86	92	Greenish Shale			
92	100	Brown Shale			

7 CONTRACTOR'S OR LANDOWNER'S CERTIFICATION: This water well was (1) constructed, (2) reconstructed, or (3) plugged under my jurisdiction and was completed on (mo/day/year) 8/10/93 and this record is true to the best of my knowledge and belief. Kansas Water Well Contractor's License No. 451 This Water Well Record was completed on (mo/day/yr) 8/19/93 under the business name of Holdeman Well Drilling by (signature) Craig J. Culp PE