


1 LOCATION OF WATER WELL: 014 Fraction NE 1/4 NE 1/4 NE 1/4 Section Number 31 Township Number T 8 S R 4 E
 County: Clay Co.

Distance and direction from nearest town or city street address of well if located within city? From Clay Center MO 6 Miles East on Braughton Rd.

2 WATER WELL OWNER: Delbert Lee Board of Agriculture, Division of Water Resources
 RR#, St. Address, Box #: 1300 Jonathan Drive Application Number:
 City, State, ZIP Code: Lawrence, KS 66049

3 LOCATE WELL'S LOCATION WITH AN "X" IN SECTION BOX:

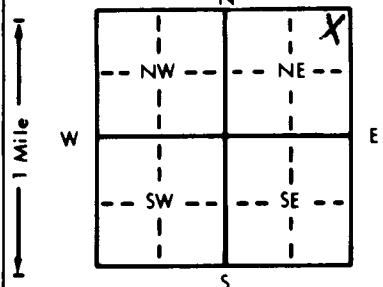

4 DEPTH OF COMPLETED WELL: 200 ft. ELEVATION: _____

Depth(s) Groundwater Encountered 1. 15.3 ft. 2. _____ ft. 3. _____ ft.

WELL'S STATIC WATER LEVEL: 14.5 ft. below land surface measured on mo/day/yr

Pump test data: Well water was _____ ft. after _____ hours pumping _____ gpm

Est. Yield: 207 gpm; Well water was _____ ft. after _____ hours pumping _____ gpm

Bore Hole Diameter: 10 in. to 200 ft., and _____ in. to _____ ft.

WELL WATER TO BE USED AS: 5 Public water supply 8 Air conditioning 11 Injection well
1 Domestic 3 Feedlot 6 Oil field water supply 9 Dewatering 12 Other (Specify below)

2 Irrigation 4 Industrial 7 Lawn and garden only 10 Monitoring well

Was a chemical/bacteriological sample submitted to Department? Yes _____ No _____; If yes, mo/day/yr sample was submitted

Water Well Disinfected? Yes No

5 TYPE OF BLANK CASING USED: 5 Wrought iron 8 Concrete tile CASING JOINTS: Glued Clamped

1 Steel 3 RMP (SR) 6 Asbestos-Cement 9 Other (specify below) Welded

2 PVC 4 ABS 7 Fiberglass Threaded

Blank casing diameter: 5" in. to 180 ft., Dia _____ in. to _____ ft., Dia _____ in. to _____ ft.

Casing height above land surface: 2 in., weight 5.26 lbs./ft. Wall thickness or gauge No. _____

TYPE OF SCREEN OR PERFORATION MATERIAL: 7 PVC 10 Asbestos-cement

1 Steel 3 Stainless steel 5 Fiberglass 8 RMP (SR) 11 Other (specify) _____

2 Brass 4 Galvanized steel 6 Concrete tile 9 ABS 12 None used (open hole)

SCREEN OR PERFORATION OPENINGS ARE: 25/1000 5 Gauzed wrapped 8 Saw cut 11 None (open hole)

1 Continuous slot 3 Mill slot 6 Wire wrapped 9 Drilled holes

2 Louvered shutter 4 Key punched 7 Torch cut 10 Other (specify) _____

SCREEN-PERFORATED INTERVALS: From 180 ft. to 200 ft., From _____ ft. to _____ ft.

GRAVEL PACK INTERVALS: From 25 ft. to 200 ft., From _____ ft. to _____ ft.

6 GROUT MATERIAL: 1 Neat cement 2 Cement grout 3 Bentonite 4 Other _____

Grout Intervals: From 0 ft. to 25 ft., From _____ ft. to _____ ft., From _____ ft. to _____ ft.

What is the nearest source of possible contamination: 10 Livestock pens 14 Abandoned water well

1 Septic tank 4 Lateral lines 7 Pit privy 11 Fuel storage 15 Oil well/Gas well

2 Sewer lines 5 Cess pool 8 Sewage lagoon 12 Fertilizer storage 16 Other (specify below)

3 Watertight sewer lines 6 Seepage pit 9 Feedyard 13 Insecticide storage

Direction from well? South How many feet? 200'

FROM	TO	LITHOLOGIC LOG	FROM	TO	PLUGGING INTERVALS
0	1	Top Soil	166	197	Limestone (Water)
1	21	Brown Clay	197	200	Grey Shale
21	38	Yellow Shale			
38	40	Limestone			
40	66	Brown Shale			
66	75	Limestone (lost circulation)			
75	92	Brown Shale			
92	93	Limestone			
93	117	Brown Shale			
117	119	Limestone			
119	126	Brown Shale			
126	144	Limestone			
144	153	Greenish shale			
153	157	Limestone (Water)			
157	166	Brown Shale			

7 CONTRACTOR'S OR LANDOWNER'S CERTIFICATION: This water well was (1) constructed, (2) reconstructed, or (3) plugged under my jurisdiction and was completed on (mo/day/year) 1/20/95 and this record is true to the best of my knowledge and belief, Kansas Water Well Contractor's License No. 451 This Water Well Record was completed on (mo/day/yr) 1/29/95 under the business name of Haldeman Well Drilling by (signature) Craig H. Haldeman

OFFICE USE ONLY

T

R

EW

SEC.

1/4

1/4

1/4