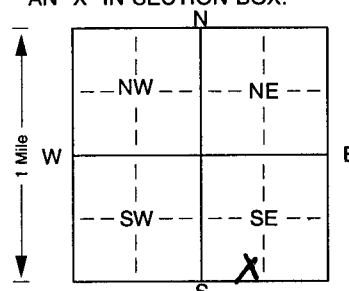


1] LOCATION OF WATER WELL: Fraction SE 1/4 SW 1/4 SE 1/4 Section Number 24 Township Number T 8 S Range Number R 5 E/W

County: RELY
 Distance and direction from nearest town or city street address of well if located within city?
2.5 MILES WEST AND 2 MILES SOUTH OF LEONARDVILLE

2] WATER WELL OWNER: RICHARD JANKIE
 RR#, St. Address, Box # : 11855 SHERMAN RD Board of Agriculture, Division of Water Resources
 City, State, ZIP Code : LEONARDVILLE, KS. 66449 Application Number: _____

3] LOCATE WELL'S LOCATION WITH AN "X" IN SECTION BOX:

 4] DEPTH OF COMPLETED WELL... 115 ft. ELEVATION: _____
 Depth(s) Groundwater Encountered 1. 110 ft. 2. _____ ft. 3. _____ ft.
 WELL'S STATIC WATER LEVEL 80 ft. below land surface measured on mo/day/yr 8/25/00
 Pump test data: Well water was _____ ft. after _____ hours pumping _____ gpm
 Est. Yield 12 gpm: Well water was _____ ft. after _____ hours pumping _____ gpm
 Bore Hole Diameter 8.75 in. to 115 ft., and _____ in. to _____ ft.
 WELL WATER TO BE USED AS: 5 Public water supply 8 Air conditioning 11 Injection well
 Domestic 3 Feedlot 6 Oil field water supply 9 Dewatering 12 Other (Specify below)
 2 Irrigation 4 Industrial 7 Domestic (lawn & garden) 10 Monitoring well _____
 Was a chemical/bacteriological sample submitted to Department? Yes. _____ No. X; If yes, mo/day/yr sample was submitted _____
 Water Well Disinfected? Yes X No _____

5] TYPE OF BLANK CASING USED:
 1 Steel 3 RMP (SR) 5 Wrought iron 8 Concrete tile CASING JOINTS: Glued _____ Clamped _____
 2 PVC 4 ABS 6 Asbestos-Cement 9 Other (specify below) Welded _____
 7 Fiberglass Threaded _____
 Blank casing diameter 5 in. to 9.5 ft., Dia _____ in. to _____ ft., Dia _____ in. to _____ ft.
 Casing height above land surface 18 in., weight _____ lbs./ft. Wall thickness or gauge No. SCH 40
 TYPE OF SCREEN OR PERFORATION MATERIAL:
 1 Steel 3 Stainless steel 5 Fiberglass 8 RMP (SR) 10 Asbestos-cement
 2 Brass 4 Galvanized steel 6 Concrete tile 9 ABS 11 Other (specify) _____
 12 None used (open hole)
 SCREEN OR PERFORATION OPENINGS ARE:
 1 Continuous slot 3 Mill slot .030 5 Gauzed wrapped 8 Saw cut 11 None (open hole)
 2 Louvered shutter 4 Key punched 6 Wire wrapped 9 Drilled holes
 7 Torch cut 10 Other (specify) _____ ft.
 SCREEN-PERFORATED INTERVALS: From 9.5 ft. to 115 ft., From _____ ft. to _____ ft.
 From _____ ft. to _____ ft., From _____ ft. to _____ ft.
 GRAVEL PACK INTERVALS: From 25 ft. to 115 ft., From _____ ft. to _____ ft.
 From _____ ft. to _____ ft., From _____ ft. to _____ ft.

6] GROUT MATERIAL: 1 Neat cement 2 Cement grout 3 Bentonite 4 Other _____
 Grout Intervals: From 3 ft. to 25 ft., From _____ ft. to _____ ft., From _____ ft. to _____ ft.
 What is the nearest source of possible contamination:
 1 Septic tank 4 Lateral lines 7 Pit privy 10 Livestock pens 14 Abandoned water well
 2 Sewer lines 5 Cess pool 8 Sewage lagoon 11 Fuel storage 15 Oil well/Gas well
 3 Watertight sewer lines 6 Seepage pit 9 Feedyard 12 Fertilizer storage 16 Other (specify below)
 13 Insecticide storage _____
 Direction from well? EAST How many feet? 300

FROM	TO	LITHOLOGIC LOG	FROM	TO	PLUGGING INTERVALS
0	8	CLAY			
8	26	SHALE, YELLOW			
26	28	LIMY SHALE, YELLOW			
28	29	LEAKSTONE, YELLOW			
29	62	SHALE, YELLOW TAN			
62	83	SHALE, RED BROWN			
83	90	LEAKSTONE, TAN			
90	115	SHALE, GRAY			

7] CONTRACTOR'S OR LANDOWNER'S CERTIFICATION: This water well was (1) constructed, (2) reconstructed, or (3) plugged under my jurisdiction and was completed on (mo/day/year) 8/25/00 and this record is true to the best of my knowledge and belief. Kansas Water Well Contractor's Licence No. 585 This Water Well Record was completed on (mo/day/yr) 9/24/00 under the business name of ASSOCIATED WATERWELL DRILLERS INC. by (signature) _____