


WWS21

1 LOCATION OF WATER WELL: County: RILEY	Fraction SW 1/4 SE 1/4 SW 1/4	Section Number 10	Township Number T 8 S	Range Number R 5 E
---	---	-----------------------------	---------------------------------	------------------------------

Distance and direction from nearest town or city street address of well if located within city?
WEST SIDE OF LEONARDVILLE NORTH SIDE OF HIGHWAY 24

2 WATER WELL OWNER: **DENNIS HAGEMAN**
 RR#, St. Address, Box # : **BOX 7**
 City, State, ZIP Code : **LEONARDVILLE KS. 66449**
 Board of Agriculture, Division of Water Resources
 Application Number: _____

3 LOCATE WELL'S LOCATION WITH AN "X" IN SECTION BOX: **X** IN SW-SE QUADRANT
 4 DEPTH OF COMPLETED WELL: **16.2** ft. ELEVATION: _____

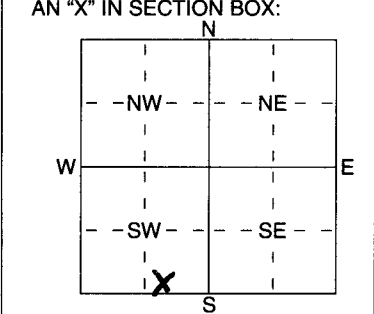

Depth(s) Groundwater Encountered 1 **14.8** ft. 2 _____ ft. 3 _____ ft.
 WELL'S STATIC WATER LEVEL **12.1** ft. below land surface measured on mo/day/yr **5/29/03**
 Pump test data: Well water was **X** ft. after _____ hours pumping _____ gpm
 Est. Yield **3.0** gpm: Well water was _____ ft. after _____ hours pumping _____ gpm
 WELL WATER TO BE USED AS:
 1 Domestic 3 Feedlot 5 Public water supply 8 Air conditioning 11 Injection well
 2 Irrigation 4 Industrial 6 Oil field water supply 9 Dewatering 12 Other (Specify below)
 7 Fiberglass 10 Monitoring well

Was a chemical/bacteriological sample submitted to Department? Yes _____ No **X**; If yes, mo/day/yr sample was submitted
 Water Well Disinfected? Yes **X** No _____

5 TYPE OF BLANK CASING USED:
 1 Steel 3 RMP (SR) 5 Wrought iron 8 Concrete tile CASING JOINTS: Glued **X** Clamped _____
 2 Brass 4 ABS 6 Asbestos-Cement 9 Other (specify below) Welded _____
 7 Fiberglass Threaded _____

Blank casing diameter **5** in. to **14.2** ft., Dia _____ in. to _____ ft., Dia _____ in. to _____ ft.
 Casing height above land surface **24** in., weight _____ lbs./ft. Wall thickness or guage No. **SDR21**

TYPE OF SCREEN OR PERFORATION MATERIAL:
 1 Steel 3 Stainless Steel 5 Fiberglass 7 **PVC** 10 Asbestos-Cement
 2 Brass 4 Galvanized Steel 6 Concrete tile 8 RMP (SR) 11 Other (Specify) _____
 9 ABS 12 None used (open hole)

SCREEN OR PERFORATION OPENINGS ARE:
 1 Continuous slot 3 **Mill slot** **1025** 5 Gauzed wrapped 8 Saw cut 11 None (open hole)
 2 Louvered shutter 4 Key punched 6 Wire wrapped 9 Drilled holes
 7 Torch cut 10 Other (specify) _____ ft.

SCREEN-PERFORATED INTERVALS: From **14.2** ft. to **16.2** ft., From _____ ft. to _____ ft.
 GRAVEL PACK INTERVALS: From **25** ft. to **16.2** ft., From _____ ft. to _____ ft.

6 GROUT MATERIAL: 1 Neat cement 2 Cement grout 3 **Bentonite** 4 Other _____
 Grout intervals: From **3** ft. to **25** ft., From _____ ft. to _____ ft., From _____ ft. to _____ ft.

What is the nearest source of possible contamination:
 1 Septic tank 4 Lateral lines 7 Pit privy 10 Livestock pens 14 Abandoned water well
 2 Sewer lines 5 Cess pool 8 Sewage lagoon 11 Fuel storage 15 Oil well/Gas well
 3 Watertight sewer lines 6 Seepage pit 9 Feedyard 12 Fertilizer storage 16 Other (specify below)
EDGE OF A FIELD
 Direction from well? _____ How many feet? _____

FROM	TO	LITHOLOGIC LOG	FROM	TO	PLUGGING INTERVALS
0	14	CLAY			
14	63	SHALE TAN			
63	96	SHALE GRAY			
96	102	LS TAN			
102	118	SHALE GRAY TO RED			
118	125	LIMESTONE			
125	148	SHALE GRAY			
148	151	LIMESTONE H2O			
151	162	SHALE TAN			
	162	TOTAL DEPTH			

7 CONTRACTOR'S OR LANDOWNER'S CERTIFICATION: This water well was **(1)** constructed, (2) reconstructed, or (3) plugged under my jurisdiction and was completed on (mo/day/year) **5/29/03** and this record is true to the best of my knowledge and belief. Kansas Water Well Contractor's Licence No **585** This Water Well Record was completed on (mo/day/yr) **6/23/03** under the business name of **ASSOCIATED WATERWELL DRILLERS INC** by (signature) _____

INSTRUCTIONS: Use typewriter or ball point pen. PLEASE PRESS FIRMLY and PRINT clearly. Please fill in blanks, underline or circle the correct answers. Send top three copies to Kansas Department of Health and Environment, Bureau of Water, Geology Section, 1000 SW Jackson St., Suite 420, Topeka, Kansas 66612-1367. Telephone 785-296-5522. Send one to WATER WELL OWNER and retain one for your records. Fee of \$5.00 for each constructed well.