


1 LOCATION OF WATER WELL: County: Riley Fraction: NE 1/4 SW 1/4 NE 1/4 Section Number: 16 Township Number: 8 Range Number: 5 E/W

Distance and direction from nearest town or city street address of well if located within city?
From Leonardville Ca 1/2 mile South on gravel Rd then Ca 300 yrd NW
in field

2 WATER WELL OWNER: Larry & LeRoy Frost
Melissa Stalham P.O.
 RR#, St. Address, Box #: 9607 Catalina St.
 City, State ZIP Code: Overland Park, KS 66207
 Global Positioning Systems (decimal degrees, min. of 4 digits)
 Latitude: _____
 Longitude: _____
 Elevation: _____
 Datum: _____
 Data Collection Method: _____

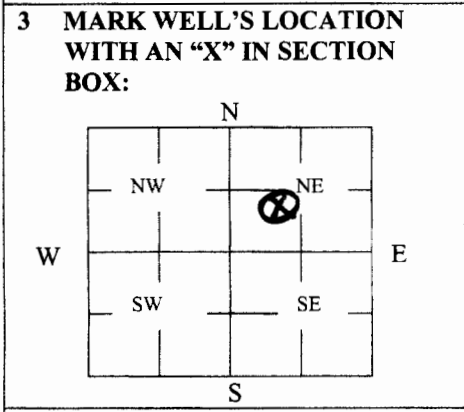

4 DEPTH OF WELL 130' ft.
WIS
 WELL'S STATIC WATER LEVEL 60 ft.
 WELL WAS USED AS:
 1 Domestic 5 Public Water Supply 9 Dewatering
 2 Irrigation 6 Oil Field Water Supply 10 Monitoring
 3 Feedlot 7 Domestic (Lawn & Garden) 11 Injection Well
 4 Industrial 8 Air Conditioning 12 Other _____
 Was a chemical/bacteriological sample submitted to Department? Yes _____ No

5 TYPE OF BLANK CASING USED:
 1 Steel 3 RMP (SR) 5 Wrought 7 Fiberglass 9 Other (Specify below)
 2 PVC 4 ABS 6 Asbestos-Cement 8 Concrete Tile Corrozinized Steel Pipe
 Blank casing diameter 5" in. Was casing pulled? Yes _____ No If yes, how much _____
 Casing height above or below land surface 3' in. Cut off 3' Below Ground

6 GROUT PLUG MATERIAL: 1 Neat cement 2 Cement grout 3 Bentonite 4 Other _____
 Grout Plug Intervals: From 3' ft. to 60' ft., From _____ ft. to _____ ft., From _____ to _____ ft.
 What is the nearest source of possible contamination: None Close
 1 Septic tank 6 Seepage pit 11 Fuel Storage 16 Other (specify below) _____
 2 Sewer lines 7 Pit privy 12 Fertilizer storage _____
 3 Watertight sewer lines 8 Sewage lagoon 13 Insecticide storage _____
 4 Laternal lines 9 Feedyard 14 Abandoned water well Direction from well? _____
 5 Cess pool 10 Livestock pens 15 Oil well/Gas well How many feet? _____

FROM	TO	PLUGGING MATERIALS	FROM	TO	PLUGGING MATERIALS
<u>0'</u>	<u>3'</u>	<u>Compacted Clay</u>			
<u>3'</u>	<u>60'</u>	<u>Bentonite Grout</u>			
<u>60'</u>	<u>130'</u>	<u>Chlorinated Sand</u>			

Plugged

7 CONTRACTOR'S OR LANDOWNER'S CERTIFICATION: This water well was plugged under my jurisdiction and was completed on (mo/day/year) 10/17/2014 and this record is true to the best of my knowledge and belief. Kansas Water Well Contractor's License No. 451. This Water Well Record was completed on (mo/day/year) 10/18/2014 under the business name of Haldeman Well Drilling by (signature) Craig H. Caldwell

INSTRUCTIONS: Use typewriter or ballpoint pen. Please press firmly and print clearly. Please fill in blanks, underline or circle the correct answers. Send top three copies to Kansas Department of Health and Environment, Bureau of Water, Geology Section, 1000 SW Jackson St., Ste. 420, Topeka, Kansas 66612-1367. Telephone: 785/296-5522. Send one to Water Well Owner and retain one for your records. Visit us at <http://www.kdheks.gov/geo/waterwells>.