USE TYPEWRITER OR BALL POINT PEN-PRESS FIRMLY, PRINT CLEARLY.

WATER WELL RECORD
KSA 82a-1201-1215

Kansas Department of Health and Environment-Division of Environment
(Water well Contractors)
Topeka, Kansas 66620

1. Location of well:	County	Fraction	Section number	Township number	Range number
	Riley	SE 1/4 SE 1/4 SE 1/4	14	T 8 S	R 5 (E) W

2. Distance and direction from nearest town or city: 1½E-1-5 of Leonarduille, KANSAS
Street address of well location if in city:

3. Owner of well: Lyle PFaFF
R.R. or ~~street~~ 1
City, state, zip code: Leonarduille, KANSAS 66449

4. Locate with "X" in section below: Sketch map:

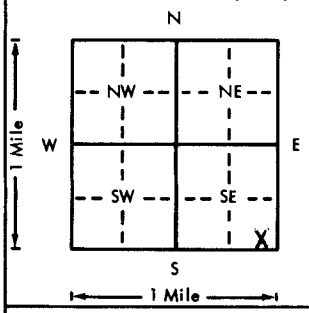

6. Bore hole dia. 8 in. Completion date 8-25-76
Well depth 140 ft.

7. X Cable tool __ Rotary __ Driven __ Dug
__ Hollow rod __ Jetted __ Bored __ Reverse rotary

8. Use: __ Domestic __ Public supply __ Industry
__ Irrigation __ Air conditioning X Stock
__ Lawn __ Oil field water __ Other

9. Casing: Material PVC Height: (Above) or below
Threaded ___ Welded Glue Surface 12 in.
RMP ___ PVC X Weight ___ lbs./ft.
Dia. 5 in. to 140 ft. depth Wall Thickness: inches or
Dia. ___ in. to ___ ft. depth gage No. 280

5. Type and color of material	From	To
Clay, Brown	0	15
Clay, yellow	15	45
Shale Brown	45	50
Lime Rock, yellow	50	55
Clay, Brown	55	65
Lime Rock, white	65	75
Shale White	75	85
Clay, White	85	90
Clay, yellow	90	100
Shale Brown	100	120
Clay, BROWN SANDY V.F.	120	135
Sandstone Rock, BROWN	135	140

(Use a second sheet if needed)

10. Screen: Manufacturer's name Slot by Driller
Type PVC Dia. 5"
(Slot) gauze 46 Length 40'
Set between 100 ft. and 140 ft.
~~55~~ ft. and ___ ft.
Gravel pack? yes Size range of material 1/16-1/2

11. Static water level: mo./day/yr.
45 ft. below land surface Date 8-25-76

12. Pumping level below land surfaces:
___ ft. after ___ hrs. pumping ___ g.p.m.
___ ft. after ___ hrs. pumping ___ g.p.m.
Estimated maximum yield ___ g.p.m.

13. Water sample submitted: mo./day/yr.
__ Yes X No Date ___

14. Well head completion:
__ Pitless adapter 12 Inches (above) grade

15. Well grouted? yes
With: X Neat cement __ Bentonite __ Concrete
Depth: From 5 ft. to 15 ft.

16. Nearest source of possible contamination: Feed
ft. 50' Direction N & E Type LOTS
Well disinfected upon completion? X Yes __ No

17. Pump: X Not installed
Manufacturer's name ___
Model number ___ HP ___ Volts ___
Length of drop pipe ___ ft. capacity ___ g.p.m.
Type:
__ Submersible __ Turbine
__ Jet __ Reciprocating
__ Centrifugal __ Other

18. Elevation:

Topography:
__ Hill
__ Slope
X Upland
__ Valley

19. Remarks: Cement Slab to be Poured by Customer

20. Water well contractor's certification:
This well was drilled under my jurisdiction and this report is true to the best of my knowledge and belief.
Harpers Drlg. Service 176
Business name License No.
Address Blue Rapids Ks
Signed C. E. Harper Date 8-25-76
Authorized representative

T 8 S R 5 (E) W Sec 14 1/4 1/4 1/4 1/4 SESESE

Forward the white, blue and pink copies to the Department of Health and Environment

Form WWC-5

M1-1023