


1 LOCATION OF WATER WELL: County: Riley Fraction: NW 1/4 SE 1/4 SW 1/4 Section Number: 20 Township Number: T 8 S 8 Range Number: R 5 E W

Distance and direction from nearest town or city street address of well if located within city? 1000' south to road on Fairview Church Rd. East 1/2 miles north on Member Rd. 2 miles, then 1/4 mile east on Highway 24 into Leonardville

2 WATER WELL OWNER: James Rudolph
 RR#, St. Address, Box #: R.1 Box 236
 City, State, ZIP Code: Riley K.S. 66531
 Board of Agriculture, Division of Water Resources
 Application Number:

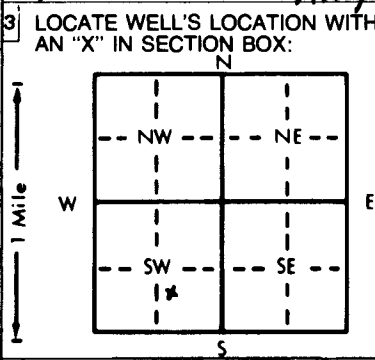

4 DEPTH OF COMPLETED WELL: 120 ft. ELEVATION: _____ ft.
 Depth(s) Groundwater Encountered: 1. 91 ft. 2. _____ ft. 3. _____ ft.
 WELL'S STATIC WATER LEVEL: 80 ft. below land surface measured on mo/day/yr _____
 Pump test data: Well water was _____ ft. after _____ hours pumping _____ gpm
 Est. Yield: 20 gpm; Well water was _____ ft. after _____ hours pumping _____ gpm
 Bore Hole Diameter: 8 in. to _____ ft., and _____ in. to _____ ft.
 WELL WATER TO BE USED AS:
 Domestic Irrigation Industrial Public water supply
 5 Public water supply 6 Oil field water supply 7 Lawn and garden only
 8 Air conditioning 9 Dewatering 10 Observation well
 11 Injection well 12 Other (Specify below): Pastured cattle
 Was a chemical/bacteriological sample submitted to Department? Yes _____ No _____
 If yes, mo/day/yr sample was submitted _____
 Water Well Disinfected? Yes No _____

5 TYPE OF BLANK CASING USED:
 1 Steel 2 PVC 3 RMP (SR) 4 ABS 5 Wrought iron 6 Asbestos-Cement 7 Fiberglass
 8 Concrete tile 9 Other (specify below) 10 Asbestos-cement
 Blank casing diameter: 5 in. to 100 ft. Dia _____ in. to _____ ft. Dia _____ in. to _____ ft.
 Casing height above land surface: 2 in. weight Sch. 40 lbs./ft. Wall thickness or gauge No. _____
 TYPE OF SCREEN OR PERFORATION MATERIAL:
 1 Steel 2 Brass 3 Stainless steel 4 Galvanized steel 5 Fiberglass 6 Concrete tile 7 PVC 8 RMP (SR) 9 ABS 10 Asbestos-cement
 11 Other (specify) _____
 12 None used (open hole)
 SCREEN OR PERFORATION OPENINGS ARE:
 1 Continuous slot 2 Mill slot 3/1000" 3 Gauzed wrapped 4 Key punched 5 Wire wrapped 6 Saw cut 7 Torch cut 8 None (open hole)
 9 Drilled holes 10 Other (specify) _____
 SCREEN-PERFORATED INTERVALS: From 100 ft. to 120 ft. From _____ ft. to _____ ft.
 GRAVEL PACK INTERVALS: From 20 ft. to 120 ft. From _____ ft. to _____ ft.

6 GROUT MATERIAL: 1 Neat cement 2 Cement grout 3 Bentonite 4 Other _____
 Grout Intervals: From 0 ft. to 20 ft. From _____ ft. to _____ ft. From _____ ft. to _____ ft.
 What is the nearest source of possible contamination: None Close
 1 Septic tank 2 Sewer lines 3 Watertight sewer lines 4 Lateral lines 5 Cess pool 6 Seepage pit 7 Pit privy 8 Sewage lagoon 9 Feedyard 10 Livestock pens 11 Fuel storage 12 Fertilizer storage 13 Insecticide storage 14 Abandoned water well 15 Oil well/Gas well 16 Other (specify below) _____
 Direction from well? Spring in woods
 How many feet? _____

FROM	TO	LITHOLOGIC LOG	FROM	TO	LITHOLOGIC LOG
0	15	Brown Clay			
15	17	Red Clay			
17	23	Brown Shale			
23	26	Rock			
26	31	Gray Shale			
31	46	Green Shale			
46	47	Rock			
47	56	Green Shale			
56	74	Brown Shale			
74	91	Red Shale			
91	111	Rock (Water)			
111	120	Gray Shale			

7 CONTRACTOR'S OR LANDOWNER'S CERTIFICATION: This water well was constructed, reconstructed, or plugged under my jurisdiction and was completed on (mo/day/year) 4/24/89 and this record is true to the best of my knowledge and belief. Kansas Water Well Contractor's License No. 451 This Water Well Record was completed on (mo/day/year) 5/129/89 under the business name of Craig Haldeman Well Drilling by (signature) Craig Haldeman

OFFICE USE ONLY
T
R
EW
SEC.