

CORRECTION TO WATER WELL RECORD (WWC-5)

The following correction(s) was made to the attached WWC-5 log, in order to file the item or to rectify lacking or incorrect information.

Fraction (1/4 1/4 1/4) Section-Township-Range changed:

listed as NE SW SW, 33-8-9S-6-7

changed to NE SW SW, 33-8S-6E

Other changes: Initial statements: _____

Changed to: _____

Comments: _____


verification method: Written description on form, and
Riley 1:24,000 topo. map. initials: ORA date: 8/23/99

submitted by: Kansas Geological Survey, Data Resources Library, 1930 Constant Ave., Lawrence, KS 66047-3726
to: Kansas Dept of Health & Environment Bureau of Water Industrial Programs, Bldg 283, Forbes Field, KS 66620

1 LOCATION OF WATER WELL: County: Riley	Fraction NE 1/4 SW 1/4 SW 1/4	Section Number 33	Township Number T -8-9- S	Range Number R -6-7- (B/W)
---	---	-----------------------------	-------------------------------------	--------------------------------------

Distance and direction from nearest town or city street address of well if located within city?
3 East & 3/4 North of Riley

2 WATER WELL OWNER: **Visser Farms (WELL #1)**
 RR#, St. Address, Box #: **9931 Madison Rd.**
 City, State, ZIP Code: **Riley, KS. 66531**
 Board of Agriculture, Division of Water Resources
 Application Number:

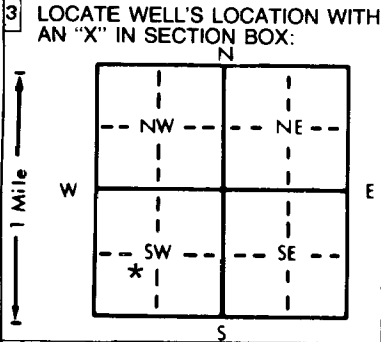

4 DEPTH OF COMPLETED WELL: **142'** ft. ELEVATION: _____ ft.

Depth(s) Groundwater Encountered 1. _____ ft. 2. _____ ft. 3. _____ ft.

WELL'S STATIC WATER LEVEL: **73** ft. below land surface measured on mo/day/yr **7/6/99**

Pump test data: Well water was _____ ft. after _____ hours pumping _____ gpm

Est. Yield **25-30** gpm: Well water was _____ ft. after _____ hours pumping _____ gpm

Bore Hole Diameter: **9** in. to **1.42** ft., and _____ in. to _____ ft.

WELL WATER TO BE USED AS:

5 Public water supply	8 Air conditioning	11 Injection well
1 Domestic	3 Feedlot	6 Oil field water supply
2 Irrigation	4 Industrial	7 Lawn and garden only
		9 Dewatering
		10 Monitoring well
		12 Other (Specify below)

Hog Building

Was a chemical/bacteriological sample submitted to Department? Yes No ; If yes, mo/day/yr sample was submitted _____

Water Well Disinfected? Yes No

5 TYPE OF BLANK CASING USED:

1 Steel	3 RMP (SR)	5 Wrought iron	8 Concrete tile	CASING JOINTS: Glued <input checked="" type="checkbox"/> Clamped _____
2 PVC	4 ABS	6 Asbestos-Cement	9 Other (specify below)	Welded _____
		7 Fiberglass		Threaded _____

Blank casing diameter: **5** in. to **1.02** ft., Dia. _____ in. to _____ ft., Dia. _____ in. to _____ ft.

Casing height above land surface: **18** in., weight **200** lbs./ft. Wall thickness or gauge No. **.265**

TYPE OF SCREEN OR PERFORATION MATERIAL:

1 Steel	3 Stainless steel	5 Fiberglass	8 RMP (SR)	10 Asbestos-cement
2 Brass	4 Galvanized steel	6 Concrete tile	9 ABS	11 Other (specify) _____
				12 None used (open hole)

SCREEN OR PERFORATION OPENINGS ARE:

1 Continuous slot	3 Mill slot	5 Gauzed wrapped	8 Saw cut	11 None (open hole)
2 Louvered shutter	4 Key punched	6 Wire wrapped	9 Drilled holes	
		7 Torch cut	10 Other (specify) _____	

SCREEN-PERFORATED INTERVALS: From **102** ft. to **142** ft., From _____ ft. to _____ ft.

GRAVEL PACK INTERVALS: From **50** ft. to **142** ft., From _____ ft. to _____ ft.

6 GROUT MATERIAL: 1 Neat cement 2 Cement grout 3 Bentonite 4 Other _____

Grout Intervals: From **5** ft. to **50** ft., From _____ ft. to _____ ft.

What is the nearest source of possible contamination:

1 Septic tank	4 Lateral lines	7 Pit privy	10 Livestock pens	14 Abandoned water well
2 Sewer lines	5 Cess pool	8 Sewage lagoon	11 Fuel storage	15 Oil well/Gas well
3 Watertight sewer lines	6 Seepage pit	9 Feedyard	12 Fertilizer storage	16 Other (specify below)
			13 Insecticide storage	

Direction from well? **SE** How many feet? **600**

FROM	TO	LITHOLOGIC LOG	FROM	TO	PLUGGING INTERVALS
0	5	Brown Clay			
5	18	Limestone			
18	27	Yellow Shale			
27	29	Flint			
29	38	Limestone & Shale			
38	42	Limestone			
42	48	Yellow Shale			
48	97	Red Shale			
97	99	Limestone			
99	116	Gray Shale			
116	119	Limestone			
119	126	Gray Shale			
126	137	Limestone Layers			
137	142	Light Gray Shale			

7 CONTRACTOR'S OR LANDOWNER'S CERTIFICATION: This water well was (1) constructed, (2) reconstructed, or (3) plugged under my jurisdiction and was completed on (mo/day/year) **7/6/99** and this record is true to the best of my knowledge and belief. Kansas Water Well Contractor's License No. **518** This Water Well Record was completed on (mo/day/yr) **7/16/99** under the business name of **Blue Valley Drilling** by (signature)