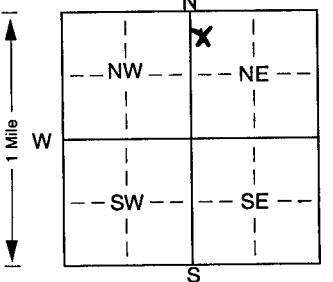


1] LOCATION OF WATER WELL: Fraction NW 1/4 NW 1/4 NE 1/4 Section Number 28 Township Number T 8 S Range Number R 6 E  
 County: Riley

Distance and direction from nearest town or city street address of well if located within city? From Riley Co, east 4 miles on 24 to 77thwy + go 2 miles to Fairview Church R. + 60 1/2 mile

2] WATER WELL OWNER: DANA Williams Riley Co Permit  
 RR#, St. Address, Box #: 9545 Fairview Church Rd. Board of Agriculture, Division of Water Resources  
 City, State, ZIP Code: Riley, MO 66531 Application Number:

3] LOCATE WELL'S LOCATION WITH AN "X" IN SECTION BOX:  4] DEPTH OF COMPLETED WELL: 100 ft. ELEVATION: ..... ft.  
 Depth(s) Groundwater Encountered: 1. 51 ft. 2. .... ft. 3. .... ft.  
 WELL'S STATIC WATER LEVEL: 80 ft. below land surface measured on mo/day/yr ..... ft.  
 Pump test data: Well water was ..... ft. after ..... hours pumping ..... gpm  
 Est. Yield: 15 gpm: Well water was ..... ft. after ..... hours pumping ..... gpm  
 Bore Hole Diameter: 9 in. to 100 ft., and ..... in. to ..... ft.  
 WELL WATER TO BE USED AS:  
 1 Domestic  3 Feedlot  6 Oil field water supply  9 Dewatering  12 Other (Specify below)   
 2 Irrigation  4 Industrial  7 Domestic (lawn & garden)  10 Monitoring well   
 Was a chemical/bacteriological sample submitted to Department? Yes. .... No. .... ; If yes, mo/day/yr sample was submitted  
 Water Well Disinfected? YES No

5] TYPE OF BLANK CASING USED:  
 1 Steel  3 RMP (SR)  5 Wrought iron  8 Concrete tile  CASING JOINTS: Glued Clamped .....  
 2 PVC  4 ABS  6 Asbestos-Cement  9 Other (specify below) Welded .....  
 7 Fiberglass  Threaded .....  
 Blank casing diameter: 5 in. to 80 ft., Dia ..... in. to ..... ft., Dia ..... in. to ..... ft.  
 Casing height above land surface: 21 in., weight Sch 40 lbs./ft. Wall thickness or gauge No. ....  
 TYPE OF SCREEN OR PERFORATION MATERIAL:  
 1 Steel  3 Stainless steel  5 Fiberglass  8 RMP (SR)  10 Asbestos-cement   
 2 Brass  4 Galvanized steel  6 Concrete tile  9 ABS  11 Other (specify) .....  
 12 None used (open hole)   
 SCREEN OR PERFORATION OPENINGS ARE:  
 1 Continuous slot  3 Mill slot 25/1500  5 Gauzed wrapped  8 Saw cut  11 None (open hole)   
 2 Louvered shutter  4 Key punched  6 Wire wrapped  9 Drilled holes   
 7 Torch cut  10 Other (specify) ..... ft.  
 SCREEN-PERFORATED INTERVALS: From: 80 ft. to 100 ft., From ..... ft. to ..... ft.  
 From: ..... ft. to ..... ft., From ..... ft. to ..... ft.  
 GRAVEL PACK INTERVALS: From: 25 ft. to 100 ft., From ..... ft. to ..... ft.  
 From: ..... ft. to ..... ft., From ..... ft. to ..... ft.

6] GROUT MATERIAL: 1 Neat cement  2 Cement grout  3 Bentonite  4 Other .....  
 Grout Intervals: From: ..... ft. to 25 ft., From ..... ft. to ..... ft.  
 What is the nearest source of possible contamination:  
 1 Septic tank  4 Lateral lines  7 Pit privy  10 Livestock pens  14 Abandoned water well   
 2 Sewer lines  5 Cess pool  8 Sewage lagoon  11 Fuel storage  15 Oil well/Gas well   
 3 Watertight sewer lines  6 Seepage pit  9 Feedyard  12 Fertilizer storage  16 Other (specify below)   
 13 Insecticide storage   
 Direction from well? South How many feet? 100

FROM	TO	LITHOLOGIC LOG	FROM	TO	PLUGGING INTERVALS
0	1	Top Soil			
1	18	Brown clay			
18	25	Limestone			
25	41	Gray shale			
41	43	Limestone			
43	51	Brown shale			
51	62	Limestone			
62	67	Brown shale			
67	71	Limestone			
71	85	Reddish brown shale			
85	93	Limestone			
93	100	Gray Silty Shale			

7] CONTRACTOR'S OR LANDOWNER'S CERTIFICATION: This water well was (1) constructed, (2) reconstructed, or (3) plugged under my jurisdiction and was completed on (mo/day/year) 8/3/2000 and this record is true to the best of my knowledge and belief. Kansas Water Well Contractor's Licence No. 451 This Water Well Record was completed on (mo/day/yr) 9/4/2000 under the business name of Haldeman Well Drilling by (signature) Wayne Coward