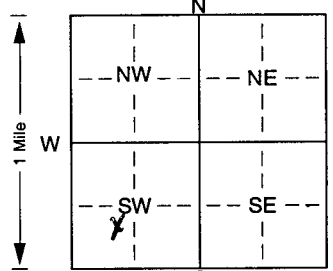


1] LOCATION OF WATER WELL: Fraction NE 1/4 SW 1/4 SW 1/4 Section Number 18 Township Number T 8 S Range Number R 10 E  
 County: Riley

Distance and direction from nearest town or city street address of well if located within city? FROM Riley go east 4 miles to T7 Hwy + go North 2 miles to Sherman Rd go west 2 miles to Walnut Creek Rd. then north 1/2 mile

2] WATER WELL OWNER: Maureen Havincorn Riley County (IIM)  
 RR#, St. Address, Box #: 824 Ewing Rd. Board of Agriculture, Division of Water Resources  
 City, State, ZIP Code: Manhattan, KS. 66503 Application Number:

3] LOCATE WELL'S LOCATION WITH AN "X" IN SECTION BOX:  
  
 4] DEPTH OF COMPLETED WELL: 100 ft. ELEVATION: ..... ft.  
 Depth(s) Groundwater Encountered 1. 50 ft. 2. .... ft. 3. .... ft.  
 WELL'S STATIC WATER LEVEL 50 ft. below land surface measured on mo/day/yr .....  
 Pump test data: Well water was ..... ft. after ..... hours pumping ..... gpm  
 Est. Yield 35 gpm Well water was ..... ft. after ..... hours pumping ..... gpm  
 Bore Hole Diameter: 9 in. to 100 ft., and ..... in. to ..... ft.  
 E WELL WATER TO BE USED AS: 5 Public water supply 8 Air conditioning 11 Injection well  
1 Domestic 3 Feedlot 6 Oil field water supply 9 Dewatering 12 Other (Specify below)  
 2 Irrigation 4 Industrial 7 Domestic (lawn & garden) 10 Monitoring well .....  
 Was a chemical/bacteriological sample submitted to Department? Yes. .... No. ....; If yes, mo/day/yr sample was submitted  
 Water Well Disinfected? Yes No

5] TYPE OF BLANK CASING USED: 5 Wrought iron 8 Concrete tile CASING JOINTS: Glued Clamped. ....  
 1 Steel 3 RMP (SR) 6 Asbestos-Cement 9 Other (specify below) Welded .....  
2 PVC 4 ABS 7 Fiberglass ..... Threaded. ....  
 Blank casing diameter 5 in. to 80 ft., Dia 80 in. to ..... ft., Dia ..... in. to ..... ft.  
 Casing height above land surface 2' in., weight 50 lb lbs./ft. Wall thickness or gauge No. ....  
 TYPE OF SCREEN OR PERFORATION MATERIAL: 10 Asbestos-cement  
 1 Steel 3 Stainless steel 5 Fiberglass 7 PVC 8 RMP (SR) 11 Other (specify) .....  
 2 Brass 4 Galvanized steel 6 Concrete tile 9 ABS 12 None used (open hole)  
 SCREEN OR PERFORATION OPENINGS ARE: 5 Gauzed wrapped 8 Saw cut 11 None (open hole)  
 1 Continuous slot 3 Mill slot 25/1000 6 Wire wrapped 9 Drilled holes  
 2 Louvered shutter 4 Key punched 7 Torch cut 10 Other (specify) ..... ft.  
 SCREEN-PERFORATED INTERVALS: From 80 ft. to 100 ft., From ..... ft. to ..... ft.  
 From ..... ft. to ..... ft., From ..... ft. to ..... ft.  
 GRAVEL PACK INTERVALS: From 25 ft. to 100 ft., From ..... ft. to ..... ft.  
 From ..... ft. to ..... ft., From ..... ft. to ..... ft.

6] GROUT MATERIAL: 1 Neat cement 2 Cement grout 3 Bentonite 4 Other .....  
 Grout Intervals: From 0 ft. to 25 ft., From ..... ft. to ..... ft., From ..... ft. to ..... ft.  
 What is the nearest source of possible contamination:  
 1 Septic tank 4 Lateral lines None Close 7 Pit privy 10 Livestock pens 14 Abandoned water well  
 2 Sewer lines 5 Cess pool 8 Sewage lagoon 11 Fuel storage 15 Oil well/Gas well  
 3 Watertight sewer lines 6 Seepage pit 9 Feedyard 12 Fertilizer storage 16 Other (specify below)  
 13 Insecticide storage .....  
 Direction from well? How many feet?

FROM	TO	LITHOLOGIC LOG	FROM	TO	PLUGGING INTERVALS
0	4	Top Soil			
4	6	Brown Clay			
6	14	Limestone			
14	24	Yellow Shale			
24	41	Greenish Shale			
41	46	Reddish Shale			
46	63	Brown Shale			
63	82	Limestone			
82	88	Greenish Shale			
88	100	Limestone			
		Brown Shale			

7] CONTRACTOR'S OR LANDOWNER'S CERTIFICATION: This water well was (1) constructed, (2) reconstructed, or (3) plugged under my jurisdiction and was completed on (mo/day/year) 4/12/2000 and this record is true to the best of my knowledge and belief. Kansas Water Well Contractor's Licence No. 4151 This Water Well Record was completed on (mo/day/yr) 7/24/2000 under the business name of Aaldeman Well Drilling by (signature) [Signature]