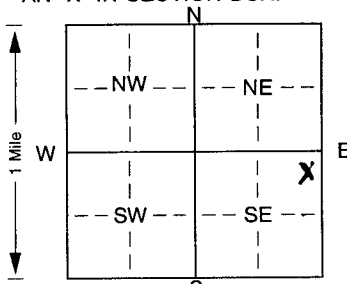


1] LOCATION OF WATER WELL: Fraction NE 1/4 IVE 1/4 SE 1/4 Section Number 30 Township Number T 8 S 6 Range Number R 6 E W
 County: Riley

Distance and direction from nearest town or city street address of well if located within city? FROM RILEY GO 1 mile east to Walnut Creek Rd + go 1.8 miles north + 1/2 west

2] WATER WELL OWNER: Jay Raymond Riley Co. Print
 RR#, St. Address, Box #: 228 N. Lake
 City, State, ZIP Code: Riley, KS, 66531
 Board of Agriculture, Division of Water Resources
 Application Number:

3] LOCATE WELL'S LOCATION WITH AN "X" IN SECTION BOX:

 4] DEPTH OF COMPLETED WELL: 120 ft. ELEVATION:
 Depth(s) Groundwater Encountered 1. 82 ft. 2. . ft. 3. . ft.
 WELL'S STATIC WATER LEVEL: 60 ft. below land surface measured on mo/day/yr
 Pump test data: Well water was . ft. after . hours pumping . gpm
 Est. Yield: 200 gpm: Well water was . ft. after . hours pumping . gpm
 Bore Hole Diameter: 9 in. to 120 ft., and . in. to . ft.
 WELL WATER TO BE USED AS:
 Domestic 3 Feedlot 6 Oil field water supply 9 Dewatering 12 Other (Specify below)
 2 Irrigation 4 Industrial 7 Domestic (lawn & garden) 10 Monitoring well .
 Was a chemical/bacteriological sample submitted to Department? Yes. . No. . ; If yes, mo/day/yr sample was submitted
 Water Well Disinfected? Yes No

5] TYPE OF BLANK CASING USED:
 1 Steel 3 RMP (SR) 5 Wrought iron 8 Concrete tile CASING JOINTS: Glued Clamped
 PVC 4 ABS 7 Fiberglass Welded
 Blank casing diameter: 5 in. to 100 ft., Dia . in. to . ft., Dia . in. to . ft.
 Casing height above land surface: 2' in., weight Sch 40 lbs./ft. Wall thickness or gauge No.
 TYPE OF SCREEN OR PERFORATION MATERIAL:
 1 Steel 3 Stainless steel 5 Fiberglass 7 PVC 10 Asbestos-cement
 2 Brass 4 Galvanized steel 6 Concrete tile 8 RMP (SR) 11 Other (specify)
 9 ABS 12 None used (open hole)
 SCREEN OR PERFORATION OPENINGS ARE:
 1 Continuous slot Mill slot 25/1000 5 Gauzed wrapped 8 Saw cut 11 None (open hole)
 2 Louvered shutter 4 Key punched 11000 6 Wire wrapped 9 Drilled holes
 7 Torch cut 10 Other (specify) ft.
 SCREEN-PERFORATED INTERVALS: From 100 ft. to 120 ft., From . ft. to . ft.
 From . ft. to . ft., From . ft. to . ft.
 GRAVEL PACK INTERVALS: From 25 ft. to 120 ft., From . ft. to . ft.
 From . ft. to . ft., From . ft. to . ft.

6] GROUT MATERIAL: 1 Neat cement 2 Cement grout Bentonite 4 Other
 Grout Intervals: From 0 ft. to 25 ft., From . ft. to . ft., From . ft. to . ft.
 What is the nearest source of possible contamination:
 1 Septic tank 4 Lateral lines None close 7 Pit privy 10 Livestock pens 14 Abandoned water well
 2 Sewer lines 5 Cess pool 8 Sewage lagoon 11 Fuel storage 15 Oil well/Gas well
 3 Watertight sewer lines 6 Seepage pit 9 Feedyard 12 Fertilizer storage 16 Other (specify below)
 13 Insecticide storage
 Direction from well? How many feet?

FROM	TO	LITHOLOGIC LOG	FROM	TO	PLUGGING INTERVALS
0	1	Top Soil			
1	21	Brown Clay			
21	32	Limestone			
32	45	Greenish Shale			
45	82	Brown Shale			
82	97	Limestone (WALC)			
97	108	Gray Shale			
108	120	Limestone			

7] CONTRACTOR'S OR LANDOWNER'S CERTIFICATION: This water well was constructed, (2) reconstructed, or (3) plugged under my jurisdiction and was completed on (mo/day/year) 4/25/2001 and this record is true to the best of my knowledge and belief. Kansas Water Well Contractor's Licence No. 451. This Water Well Record was completed on (mo/day/yr) 5/11/2001 under the business name of Haldeman Well Drilling by (signature) [Signature]