

**CORRECTION(S) TO WATER WELL RECORD (WWC-5)**

(to rectify lacking or incorrect information)

County: Riley

Location listed as:

Section-Township-Range: 35-85S-6E

Fraction ( 1/4 1/4 1/4): NE NE SE

Location changed to:

35-85-6E

NE NE SE

Other changes: Initial statements: \_\_\_\_\_

Changed to: \_\_\_\_\_

Comments: \_\_\_\_\_

verification method: Written & legal descriptions, area map on internet, position on plat map, and Olsburg SW 1:24,000 topo. map.

initials: DRK date: 4/2/2003

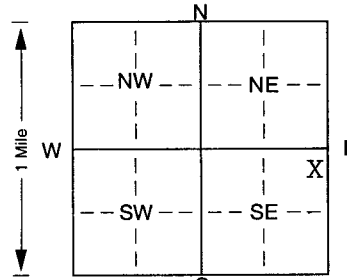
submitted by: Kansas Geological Survey, Data Resources Library, 1930 Constant Ave., Lawrence, KS 66047-3726

to: Kansas Dept of Health & Environment, Bureau of Water, 1000 SW Jackson, Suite 420, Topeka, KS 66612-1367.

1 LOCATION OF WATER WELL: Fraction NE 1/4 NE 1/4 SE 1/4 Section Number 35 Township Number T 85 S Range Number R 6E EW  
 County: Riley

Distance and direction from nearest town or city street address of well if located within city?  
7490 Stockdale Park Rd

2 WATER WELL OWNER: Rod Taylor  
 RR#, St. Address, Box #: 7490 Stockdale Park Rd Board of Agriculture, Division of Water Resources  
 City, State, ZIP Code: Manhattan, Ks 66503 Application Number:

3 LOCATE WELL'S LOCATION WITH AN "X" IN SECTION BOX:  
  
 4 DEPTH OF COMPLETED WELL: 6.0 ft. ELEVATION:  
 Depth(s) Groundwater Encountered 1. .... ft. 2. .... ft. 3. .... ft.  
 WELL'S STATIC WATER LEVEL 2.5 ft. below land surface measured on mo/day/yr 1-9-2003  
 Pump test data: Well water was .... ft. after .... hours pumping .... gpm  
 Est. Yield 4 gpm: Well water was .... ft. after .... hours pumping .... gpm  
 Bore Hole Diameter: 8 3/4 in. to .... ft., and .... in. to .... ft.  
 WELL WATER TO BE USED AS: 5 Public water supply 8 Air conditioning 11 Injection well  
1 Domestic 3 Feedlot 6 Oil field water supply 9 Dewatering 12 Other (Specify below)  
2 Irrigation 4 Industrial 7 Domestic (lawn & garden) 10 Monitoring well  
 Was a chemical/bacteriological sample submitted to Department? Yes. .... No. X; If yes, mo/day/yr sample was submitted  
 Water Well Disinfected? Yes X No

5 TYPE OF BLANK CASING USED:  
 1 Steel 3 RMP (SR) 5 Wrought iron 8 Concrete tile CASING JOINTS: Glued. X Clamped. ....  
 2 PVC 4 ABS 6 Asbestos-Cement 9 Other (specify below) Welded .....  
 7 Fiberglass Threaded.....  
 Blank casing diameter 5 in. to .... ft., Dia 5 in. to .... ft., Dia ..... in. to .... ft.  
 Casing height above land surface 24 in., weight 2.82 lbs./ft. Wall thickness or gauge No. 258  
 TYPE OF SCREEN OR PERFORATION MATERIAL:  
 1 Steel 3 Stainless steel 5 Fiberglass 7 PVC 10 Asbestos-cement  
 2 Brass 4 Galvanized steel 6 Concrete tile 8 RMP (SR) 11 Other (specify) .....  
 9 ABS 12 None used (open hole)  
 SCREEN OR PERFORATION OPENINGS ARE:  
 1 Continuous slot 3 Mill slot 5 Gauzed wrapped 8 Saw cut 11 None (open hole)  
 2 Louvered shutter 4 Key punched 6 Wire wrapped 9 Drilled holes  
 7 Torch cut 10 Other (specify) ..... ft.  
 SCREEN-PERFORATED INTERVALS: From 25 ft. to 45 ft., From ..... ft. to ..... ft.  
 From ..... ft. to ..... ft., From ..... ft. to ..... ft.  
 GRAVEL PACK INTERVALS: From 24 ft. to 60 ft., From ..... ft. to ..... ft.  
 From ..... ft. to ..... ft., From ..... ft. to ..... ft.

6 GROUT MATERIAL: 1 Neat cement 2 Cement grout 3 Bentonite 4 Other .....  
 Grout Intervals: From 2 ft. to 24 ft., From ..... ft. to ..... ft., From ..... ft. to ..... ft.  
 What is the nearest source of possible contamination:  
 1 Septic tank 4 Lateral lines 7 Pit privy 10 Livestock pens 14 Abandoned water well  
 2 Sewer lines 5 Cess pool 8 Sewage lagoon 11 Fuel storage 15 Oil well/Gas well  
 3 Watertight sewer lines 6 Seepage pit 9 Feedyard 12 Fertilizer storage 16 Other (specify below)  
Ditch  
 Direction from well? East How many feet? 25

FROM	TO	LITHOLOGIC LOG	FROM	TO	PLUGGING INTERVALS
<del>-1</del> -0	<del>-7</del> -1	top soil	28	30	shale yellow
<del>-7</del> -1	7	clay brown loose rocks	30	32	shale grey
7	9	shale brown	32	33	limestone yellow loose
9	10	limestone yellow	33	34	shale yellow soft
10	11	shale yellow	34	36	shale grey
11	12	shale red	36	39	gyp
12	13	shale grey	39	45	shale grey
13	19	shale yellow	45	47	shale red
19	23	shale grey	47	49	shale grey soft
23	24	limestone grey	49	51	shale blue grey
24	25	shale yellow	51	54	limestone grey
25	26	shale grey	54	55	shale black
26	27	limestone grey	55	56	limestone bl grey flinty
27	28	limestone yellow	56	<del>57</del> 60	grey shale <del>rocky</del>

7 CONTRACTOR'S OR LANDOWNER'S CERTIFICATION: This water well was (1) constructed, (2) reconstructed, or (3) plugged under my jurisdiction and was completed on (mo/day/year) 2-26-2003 and this record is true to the best of my knowledge and belief. Kansas Water Well Contractor's Licence No. 182 This Water Well Record was completed on (mo/day/yr) 3-4-2003 under the business name of Strader Drilling Co., Inc. by (signature) Dale Skren