


1 LOCATION OF WATER WELL: Fraction SE 1/4 SE 1/4 SE 1/4 Section Number 22 Township Number T 8 S Range Number R 6 (EW)  
 County: Riley

Distance and direction from nearest town or city street address of well if located within city?

2 North & 5 East of Riley

2 WATER WELL OWNER: Barry Fickbohm GPS 39°20.177N 096°44.355W  
 RR#, St. Address, Box # : 924 Autumn Drive Board of Agriculture, Division of Water Resources  
 City, State, ZIP Code : Antioch, Illinois 60002 Application Number:

3 LOCATE WELL'S LOCATION WITH AN "X" IN SECTION BOX:

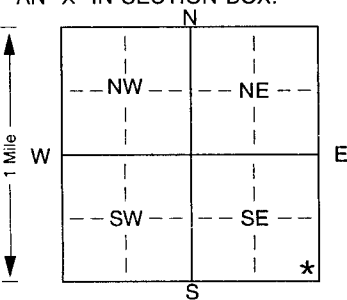

4 DEPTH OF COMPLETED WELL: 80 ft. ELEVATION: .....

Depth(s) Groundwater Encountered 1. .... ft. 2. .... ft. 3. .... ft.  
 WELL'S STATIC WATER LEVEL: 5.5 ft. below land surface measured on mo/day/yr 3/29/02  
 Pump test data: Well water was ..... ft. after ..... hours pumping ..... gpm  
 Est. Yield 25 gpm; Well water was ..... ft. after ..... hours pumping ..... gpm  
 Bore Hole Diameter: 8 1/2 in. to ..... ft., and ..... in. to ..... ft.  
 WELL WATER TO BE USED AS: 5 Public water supply 8 Air conditioning 11 Injection well  
1 Domestic 3 Feedlot 6 Oil field water supply 9 Dewatering 12 Other (Specify below)  
 2 Irrigation 4 Industrial 7 Domestic (lawn & garden) 10 Monitoring well .....

Was a chemical/bacteriological sample submitted to Department? Yes. .... No. \* .. ; If yes, mo/day/yr sample was submitted  
 Water Well Disinfected? Yes \* No

5 TYPE OF BLANK CASING USED: 5 Wrought iron 8 Concrete tile CASING JOINTS: Glued. \* .. Clamped ..  
 1 Steel 3 RMP (SR) 6 Asbestos-Cement 9 Other (specify below) Welded ..  
2 PVC 4 ABS 7 Fiberglass .. Threaded. ....  
 Blank casing diameter XX 5 in. to 60 ft., Dia ..... in. to ..... ft., Dia ..... in. to ..... ft.  
 Casing height above land surface 18 in., weight 200 lbs./ft. Wall thickness or gauge No. 265  
 TYPE OF SCREEN OR PERFORATION MATERIAL: 7 PVC 10 Asbestos-cement  
 1 Steel 3 Stainless steel 5 Fiberglass 8 RMP (SR) 11 Other (specify) ..  
 2 Brass 4 Galvanized steel 6 Concrete tile 9 ABS 12 None used (open hole)  
 SCREEN OR PERFORATION OPENINGS ARE: 5 Gauzed wrapped 8 Saw cut 11 None (open hole)  
1 Continuous slot 3 Mill slot 6 Wire wrapped 9 Drilled holes  
 2 Louvered shutter 4 Key punched 7 Torch cut 10 Other (specify) ..... ft.  
 SCREEN-PERFORATED INTERVALS: From 60 ft. to 80 ft., From ..... ft. to ..... ft.  
 From ..... ft. to ..... ft., From ..... ft. to ..... ft.  
 GRAVEL PACK INTERVALS: From 30 ft. to 80 ft., From ..... ft. to ..... ft.  
 From ..... ft. to ..... ft., From ..... ft. to ..... ft.

6 GROUT MATERIAL: 1 Neat cement 2 Cement grout 3 Bentonite 4 Other ..  
 Grout Intervals: From 5 ft. to 30 ft., From ..... ft. to ..... ft., From ..... ft. to ..... ft.  
 What is the nearest source of possible contamination: 10 Livestock pens 14 Abandoned water well  
 1 Septic tank 4 Lateral lines 7 Pit privy 11 Fuel storage 15 Oil well/Gas well  
 2 Sewer lines 5 Cess pool 8 Sewage lagoon 12 Fertilizer storage 16 Other (specify below)  
 3 Watertight sewer lines 6 Seepage pit 9 Feedyard 13 Insecticide storage .....

Direction from well? None Present How many feet?

FROM	TO	LITHOLOGIC LOG	FROM	TO	PLUGGING INTERVALS
0	10	Brown Clay			
10	12	Yellow Shale			
12	27	Limestone & Shale			
27	59	Gray Shale			
59	74	Gray Limestone			
74	82	Gray Shale			

7 CONTRACTOR'S OR LANDOWNER'S CERTIFICATION: This water well was (1) constructed, (2) reconstructed, or (3) plugged under my jurisdiction and was completed on (mo/day/year) 3/29/02 and this record is true to the best of my knowledge and belief. Kansas Water Well Contractor's Licence No. 518. This Water Well Record was completed on (mo/day/yr) 4/2/02 under the business name of Blue Valley Drilling by (signature) Barry Fickbohm