

WATER WELL RECORD


Form WWC-5

Division of Water Resources App. No.

1 LOCATION OF WATER WELL: County: Riley Co. Fraction: SW 1/4 SW 1/4 SE 1/4 1/4 Section Number: 22 Township No. T 8 S Range Number R 6 E W

Street/Rural Address of Well Location; if unknown, distance & direction from nearest town or intersection: If at owner's address, check here. From Randolph Co 8 miles south on 77 day To Fairview Church Rd, then go 1/2 mile East

2 WATER WELL OWNER: RR#, Street Address, Box #: Michael Beebe 1176 Meadowbrook Ln. Manhattan, KS 66503

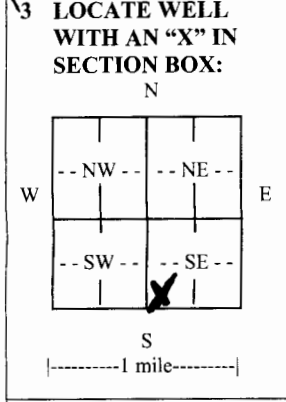

3 LOCATE WELL WITH AN 'X' IN SECTION BOX: 4 DEPTH OF COMPLETED WELL 100 ft. Depth(s) Groundwater Encountered (1) 42 ft. (2) ft. (3) ft. WELL'S STATIC WATER LEVEL 25 ft. below land surface measured on mo/day/yr. Pump test data: Well water was ft. after hours pumping gpm EST. YIELD 2 gpm Well water was ft. after hours pumping gpm Bore Hole Diameter 9 in. to 100 ft. and in. to ft. WELL WATER TO BE USED AS: Domestic, Feedlot, Oil field water supply, Geothermal, Injection well, Irrigation, Industrial, Domestic-lawn & garden, Dewatering, Other (Specify below), Monitoring well. Was a chemical/bacteriological sample submitted to Department? Yes No. If yes, mo/day/yr sample was submitted. Water well disinfected? Yes No

5 TYPE OF CASING USED: Steel, PVC, Other. CASING JOINTS: Glued, Clamped, Welded, Threaded. Casing diameter 5 in. to 80 ft., Diameter in. to ft., Diameter in. to ft. Casing height above land surface 31 in., Weight 50 lb/ft., Wall thickness or gauge No. TYPE OF SCREEN OR PERFORATION MATERIAL: Steel, Stainless Steel, PVC, Brass, Galvanized Steel, None used (open hole). SCREEN OR PERFORATION OPENINGS ARE: Continuous slot, Mill slot, Gauze wrapped, Torch cut, Drilled holes, None (open hole), Louvered shutter, Key punched, Wire wrapped, Saw cut, Other (specify). SCREEN-PERFORATED INTERVALS: From 80 ft. to 100 ft., From ft. to ft., From ft. to ft. GRAVEL PACK INTERVALS: From 28 ft. to 100 ft., From ft. to ft., From ft. to ft.

6 GROUT MATERIAL: Neat cement, Cement grout, Bentonite, Other. Grout Intervals: From 5 ft. to 28 ft., From ft. to ft., From ft. to ft. What is the nearest source of possible contamination: Septic tank, Lateral lines, Pit privy, Livestock pens, Insecticide storage, Other (specify below), Sewer lines, Cesspool, Sewage lagoon, Fuel storage, Abandoned water well, Watertight sewer lines, Seepage pit, Feedyard, Fertilizer storage, Oil well/gas well. Direction from well Distance from well

Table with columns: FROM, TO, LITHOLOGIC LOG, FROM, TO, LITHO. LOG (cont.) or PLUGGING INTERVALS. Rows include: 0-1 Top Soil, 1-14 Brown clay, 14-28 Yellow shale, 28-30 Limestone, 30-42 Tan shale, 42-44 Limestone, 44-47 Brown shale (water), 47-60 Grey oily shale, 60-67 Limestone, 67-76 Grey oily shale.

7 CONTRACTOR'S OR LANDOWNER'S CERTIFICATION: This water well was constructed, reconstructed, or plugged under my jurisdiction and was completed on (mo/day/year) 5/19/2012 and this record is true to the best of my knowledge and belief. Kansas Water Well Contractor's License No. 451. This Water Well Record was completed on (mo/day/year) 5/27/2012 under the business name of Kalkman Well Drilling by (signature) Craig M. Culp, PE

INSTRUCTIONS: Use typewriter or ball point pen. PLEASE PRESS FIRMLY and PRINT clearly. Please fill in blanks and check the correct answers. Send three copies (white, blue, pink) to Kansas Department of Health and Environment, Bureau of Water, Geology Section, 1000 SW Jackson St., Suite 420, Topeka, Kansas 66612-1367. Telephone 785-296-5524. Send one copy to WATER WELL OWNER and retain one for your records. Include fee of \$5.00 for each constructed well. Visit us at http://www.kdheks.gov/waterwell/index.html.