

WATER WELL RECORD Form WWC-5


Original Record Correction Change in Well Use

Division of Water Resources App. No.

Well ID

1 LOCATION OF WATER WELL:
 County: Riley Co. Fraction SE 4 SE 4 SW 4 Section Number 10 Township Number T 8 S Range Number R 6 E

2 WELL OWNER: Last Name: FASSO First: DOUG
 Business Address: 212 N. MAIN
 City: Riley State: KS ZIP: 66531
 Street or Rural Address where well is located (if unknown, distance and direction from nearest town or intersection): If at owner's address, check here:
FROM RANDOLPH 60 1/2 MILES SOUTH ON 77 HWY TO BARTON RD THEN 60 1/2 MILES EAST

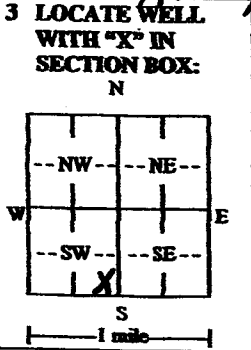

4 DEPTH OF COMPLETED WELL: 100 ft.
 Depth(s) Groundwater Encountered: 1) 40 ft.
 2) _____ ft. 3) _____ ft. or 4) Dry Well
WELL'S STATIC WATER LEVEL: 40 ft.
 below land surface, measured on (mo-day-yr) 8/6/2020
 above land surface, measured on (mo-day-yr) _____
 Pump test data: Well water was _____ ft. after _____ hours pumping _____ gpm
 Well water was _____ ft. after _____ hours pumping _____ gpm
 Estimated Yield: 1 gpm
 Bore Hole Diameter: 9 1/4 in. to 100 ft. and _____ in. to _____ ft.

5 Latitude: N 39° 21.924 (decimal degrees)
Longitude: W 096° 44.751 (decimal degrees)
 Horizontal Datum: WGS 84 NAD 83 NAD 27
 Source for Latitude/Longitude:
 GPS (unit make/model: Garmin E-Trex 20) (WAAS enabled? Yes No)
 Land Survey Topographic Map
 Online Mapper: _____
6 Elevation: 1195 ft. Ground Level TOC
 Source: Land Survey GPS Topographic Map
 Other _____

7 WELL WATER TO BE USED AS:

1. Domestic: <input checked="" type="checkbox"/> Household <input type="checkbox"/> Lawn & Garden <input type="checkbox"/> Livestock	2. <input type="checkbox"/> Irrigation	3. <input type="checkbox"/> Feedlot	4. <input type="checkbox"/> Industrial	5. <input type="checkbox"/> Public Water Supply: well ID _____	6. <input type="checkbox"/> Dewatering: how many wells? _____	7. <input type="checkbox"/> Aquifer Recharge: well ID _____	8. <input type="checkbox"/> Monitoring: well ID _____	9. Environmental Remediation: well ID _____ <input type="checkbox"/> Air Sparge <input type="checkbox"/> Soil Vapor Extraction <input type="checkbox"/> Recovery <input type="checkbox"/> Injection	10. <input type="checkbox"/> Oil Field Water Supply: lease _____	11. Test Hole: well ID _____ <input type="checkbox"/> Cased <input type="checkbox"/> Uncased <input type="checkbox"/> Geotechnical	12. Geothermal: how many bores? _____ a) Closed Loop <input type="checkbox"/> Horizontal <input type="checkbox"/> Vertical b) Open Loop <input type="checkbox"/> Surface Discharge <input type="checkbox"/> Inj. of Water	13. <input type="checkbox"/> Other (specify): _____
---	--	-------------------------------------	--	--	---	---	---	---	--	---	---	---

Was a chemical/bacteriological sample submitted to KDHE? Yes No If yes, date sample was submitted: _____
 Water well disinfected? Yes No

8 TYPE OF CASING USED: Steel PVC Other _____ CASING JOINTS: Glued Clamped Welded Threaded
 Casing diameter 5 in. to 8 1/2 ft. Diameter _____ in. to _____ ft. Diameter _____ in. to _____ ft.
 Casing height above land surface 2 in. Weight 5440 lbs./ft. Wall thickness or gauge No. _____

TYPE OF SCREEN OR PERFORATION MATERIAL:
 Steel Stainless Steel Fiberglass PVC
 Brass Galvanized Steel Concrete tile None used (open hole) Other (Specify) _____

SCREEN OR PERFORATION OPENINGS ARE:
 Continuous Slot Mill Slot Gauze Wrapped Torch Cut Drilled Holes Other (Specify) _____
 Louvered Shutter Key Punched Wire Wrapped Saw Cut None (Open Hole)

SCREEN-PERFORATED INTERVALS: From 80 ft. to 100 ft. From _____ ft. to _____ ft. From _____ ft. to _____ ft.
GRAVEL PACK INTERVALS: From _____ ft. to _____ ft. From _____ ft. to _____ ft. From _____ ft. to _____ ft.

9 GROUT MATERIAL: Neat cement Cement grout Bentonite Other _____
 Grout intervals: From 5 ft. to 29 ft. From _____ ft. to _____ ft. From _____ ft. to _____ ft.

Nearest source of possible contamination: None Close
 Septic Tank Lateral Lines Pit Privy Livestock Pens Insecticide Storage
 Sewer Lines Cess Pool Sewage Lagoon Fuel Storage Abandoned Water Well
 Watertight Sewer Lines Seepage Pit Feedyard Fertilizer Storage Oil Well/Gas Well
 Other (Specify) _____

Direction from well? _____ Distance from well? _____ ft.

10 FROM	TO	LITHOLOGIC LOG	FROM	TO	LITHO. LOG (cont.) or PLUGGING INTERVALS
0	1	Top Soil			
1	19	Limestone			
19	29	Grey Shale			
29	34	Limestone			
34	37	Tan Shale			
37	49	Limestone (Water)			
49	82	Tan Shale			
82	90	Brown Shale			
90	100	Dark Grey Silty Shale			

Notes: _____

11 CONTRACTOR'S OR LANDOWNER'S CERTIFICATION: This water well was constructed, reconstructed, or plugged under my jurisdiction and was completed on (mo-day-yr) 8/6/2020 and this record is true to the best of my knowledge and belief.
 Kansas Water Well Contractor's License No. 451 This Water Well Record was completed on (mo-day-yr) 8/19/2020
 under the business name of Holdman Well Drilling