


OFFICE USE ONLY
T
R
EW
SEC.

1 LOCATION OF WATER WELL: County: Riley Co. Fraction: NE 1/4 SE 1/4 SE 1/4 Section Number: 4 Township Number: T 8 S Range Number: R 6 E
 Distance and direction from nearest town or city street address of well if located within city? 3 miles South of Randolph on U.S. 77 to Baldwin Creek Rd. Turn West for 1/8 mile, then turn south for 1/8 mile

2 WATER WELL OWNER: Harold E. Klaassen
 RR#, St. Address, Box #: 3009 Conrow Dr. Board of Agriculture, Division of Water Resources
 City, State, ZIP Code: Manhattan K.S. 66502 Application Number:

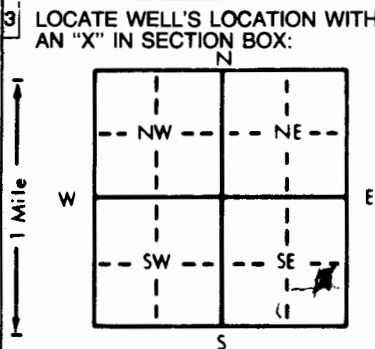

4 DEPTH OF COMPLETED WELL: 80' ft. ELEVATION: ft.
 Depth(s) Groundwater Encountered 1. 22' ft. 2. ft. 3. ft.
 WELL'S STATIC WATER LEVEL: 15' ft. below land surface measured on mo/day/yr ft.
 Pump test data: Well water was ft. after hours pumping gpm
 Est. Yield: 1.5 gpm; Well water was ft. after hours pumping gpm
 Bore Hole Diameter: 8" in. to 8.0 in. to in. to ft.
 WELL WATER TO BE USED AS:
 1 Domestic 3 Feedlot 6 Oil field water supply 9 Dewatering 12 Other (Specify below)
 2 Irrigation 4 Industrial 7 Lawn and garden only 10 Monitoring well
 Was a chemical/bacteriological sample submitted to Department? Yes..... No.....; If yes, mo/day/yr sample was submitted
 Water Well Disinfected? Yes No

5 TYPE OF BLANK CASING USED:
 1 Steel 3 RMP (SR) 6 Asbestos-Cement 9 Other (specify below)
 2 PVC 4 ABS 7 Fiberglass
 Blank casing diameter: 5 in. to 60' ft. Dia. in. to ft. Dia. in. to ft.
 Casing height above land surface: 2' in., weight: Sch. 4.0 lbs./ft. Wall thickness or gauge No.
 TYPE OF SCREEN OR PERFORATION MATERIAL:
 1 Steel 3 Stainless steel 5 Fiberglass 7 PVC 10 Asbestos-cement
 2 Brass 4 Galvanized steel 6 Concrete tile 9 ABS 11 Other (specify)
 12 None used (open hole)
 SCREEN OR PERFORATION OPENINGS ARE:
 1 Continuous slot 3 Mill slot 3/1000's 5 Gauzed wrapped 8 Saw cut 11 None (open hole)
 2 Louvered shutter 4 Key punched 6 Wire wrapped 9 Drilled holes
 7 Torch cut 10 Other (specify)
 SCREEN-PERFORATED INTERVALS: From 6.0 ft. to 80' ft. From ft. to ft.
 From 20 ft. to 30' ft. From ft. to ft.
 GRAVEL PACK INTERVALS: From 20 ft. to 80' ft. From ft. to ft.
 From ft. to ft. From ft. to ft.

6 GROUT MATERIAL: 1 Neat cement 2 Cement grout 3 Bentonite 4 Other
 Grout intervals: From 0 ft. to 20 ft. From ft. to ft. From ft. to ft.
 What is the nearest source of possible contamination:
 1 Septic tank 4 Lateral lines 7 Pit privy 10 Livestock pens 14 Abandoned water well
 2 Sewer lines 5 Cess pool 8 Sewage lagoon 11 Fuel storage 15 Oil well/Gas well
 3 Watertight sewer lines 6 Seepage pit 9 Feedyard 12 Fertilizer storage 16 Other (specify below)
 13 Insecticide storage
 Direction from well? EAST How many feet? 250'

FROM	TO	LITHOLOGIC LOG	FROM	TO	PLUGGING INTERVALS
0	8	Brown Clay			
9	14	Rock			
14	15	Gray Clay			
15	16	Rock			
16	22	Shale			
22	27	Limestone (Water)			
27	30	Gray Shale			
30	42	Rock			
42	57	Gray shale			
57	69	Brown shale			
69	73	Rock			
73	80	Gray Shale			

7 CONTRACTOR'S OR LANDOWNER'S CERTIFICATION: This water well was (1) constructed, (2) reconstructed, or (3) plugged under my jurisdiction and was completed on (mo/day/year) 5/4/89 and this record is true to the best of my knowledge and belief. Kansas Water Well Contractor's License No. 451 This Water Well Record was completed on (mo/day/yr) 5/29/89 under the business name of Craig Halderman Well Drilling by (signature) Craig Halderman

INSTRUCTIONS: Use typewriter or ball point pen. PLEASE PRESS FIRMLY and PRINT clearly. Please fill in blanks, underline or circle the correct answers. Send top three copies to Kansas Department of Health and Environment, Bureau of Water Protection, Topeka, Kansas 66620-7320. Telephone: 913-296-5514. Send one to WATER WELL OWNER and retain one for your records.