


1 LOCATION OF WATER WELL: County: Riley Fraction: SE 1/4 SE 1/4 NE 1/4 Section Number: 6 Township Number: T 8 S 2 Range Number: R 6 E
 Distance and direction from nearest town or city street address of well if located within city? 893 South West 4 Miles From Randolph Twp County

2 WATER WELL OWNER: City of Randolph RR#, St. Address, Box #: City Building Board of Agriculture, Division of Water Resources
 City, State, ZIP Code: Randolph, Kansas 66554 Application Number:

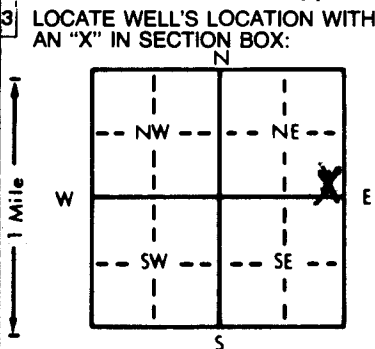

4 DEPTH OF COMPLETED WELL: 181 ft. ELEVATION: ft.
 Depth(s) Groundwater Encountered 1. 105 ft. 2. 180 ft. 3. ft.
 WELL'S STATIC WATER LEVEL: 105 ft. below land surface measured on mo/day/yr
 Pump test data: Well water was ft. after hours pumping gpm
 Est. Yield: 50 gpm. Well water was hours pumping gpm
 Bore Hole Diameter: 8 in. to 181 in. and in. to ft.
 WELL WATER TO BE USED AS: 5 Public water supply 8 Air conditioning 11 Injection well
 1 Domestic 3 Feedlot 6 Oil field water supply 9 Dewatering 12 Other (Specify below)
 2 Irrigation 4 Industrial 7 Lawn and garden only 10 Monitoring well 101 No. For Public
 Was a chemical/bacteriological sample submitted to Department? Yes Yes No; If yes, mo/day/yr sample was submitted
 Water Well Disinfected? Yes No

5 TYPE OF BLANK CASING USED: 1 Steel 3 RMP (SR) 6 Asbestos-Cement 9 Other (specify below) Welded Screwed
 2 PVC 4 ABS 7 Fiberglass Threaded
 Blank casing diameter: 5 in. to 140 ft. Dia. in. to ft. Dia. in. to ft.
 Casing height above land surface: 5 in., weight Sch. 40 lbs./ft. Wall thickness or gauge No.
 TYPE OF SCREEN OR PERFORATION MATERIAL: PVC 10 Asbestos-cement
 1 Steel 3 Stainless steel 5 Fiberglass 8 RMP (SR) 11 Other (specify)
 2 Brass 4 Galvanized steel 6 Concrete tile 9 ABS 12 None used (open hole)
 SCREEN OR PERFORATION OPENINGS ARE: 3 Mill slot 21,000's 5 Gauzed wrapped 8 Saw cut 11 None (open hole)
 1 Continuous slot 6 Wire wrapped 9 Drilled holes
 2 Louvered shutter 4 Key punched 7 Torch cut 10 Other (specify)
 SCREEN-PERFORATED INTERVALS: From 141 ft. to 181 ft. From ft. to ft.
 GRAVEL PACK INTERVALS: From None (Temporary) ft. From ft. to ft.
 From Temporary ft. to ft. From ft. to ft.

6 GROUT MATERIAL: 1 Neat cement 2 Cement grout 3 Bentonite 4 Other OTB 10
 Grout intervals: From 0 ft. to 10 ft. From ft. to ft. From ft. to ft.
 What is the nearest source of possible contamination: None Close 10 Livestock pens 14 Abandoned water well
 1 Septic tank 4 Lateral lines 7 Pit privy 11 Fuel storage 15 Oil well/Gas well
 2 Sewer lines 5 Cess pool 8 Sewage lagoon 12 Fertilizer storage 16 Other (specify below)
 3 Watertight sewer lines 6 Seepage pit 9 Feedyard 13 Insecticide storage
 Direction from well? How many feet?

FROM	TO	LITHOLOGIC LOG	FROM	TO	PLUGGING INTERVALS
0	6	Brown Clay			
6	14	Gray Shale			
14	15	Limestone			
15	42	Gray + Green Shale			
42	85	Limestone			
85	74	Gray + Green Shale			
74	75	Limestone			
75	89	Gray, Green Shale			
89	106	Limestone TRAIL OF WATER			
106	114	Gray Shale			
114	115	Limestone			
115	160	Gray + Red Shale			
160	171	Limestone (Water)			
171	181	Gray Shale			

7 CONTRACTOR'S OR LANDOWNER'S CERTIFICATION: This water well was (1) constructed, (2) reconstructed, or (3) plugged under my jurisdiction and was completed on (mo/day/year) 2/13/90 and this record is true to the best of my knowledge and belief. Kansas Water Well Contractor's License No. 451 This Water Well Record was completed on (mo/day/year) 4/21/90 under the business name of Haldeman Well Drilling by (signature) Craig H. Haldeman

OFFICE USE ONLY
T
R
EW
SEC.