


OFFICE USE ONLY
T
R
EW
SEC.
1/4
1/4
1/4

1 LOCATION OF WATER WELL: County: Riley Fraction: SW 1/4 NE 1/4 NE 1/4 Section Number: 12 Township Number: T 8 S Range Number: R 6 E

Distance and direction from nearest town or city street address of well if located within city? From Randolph GO South 6 Miles on 77th to University Park Blvd. Turn COO East 3 miles to Lakeside Drive + GO 2 miles North West

2 WATER WELL OWNER: ANN M. HAWKS
RR#, St. Address, Box #: 10711 Lakeside Dr. Board of Agriculture, Division of Water Resources
City, State, ZIP Code: Manhattan, KS 66502 Application Number:

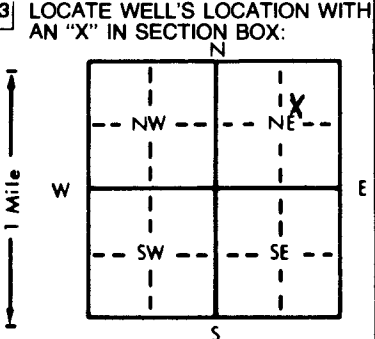

4 DEPTH OF COMPLETED WELL: 260' ft. ELEVATION:
Depth(s) Groundwater Encountered 1. 194' ft. 2. ft. 3. ft.
WELL'S STATIC WATER LEVEL: 190' ft. below land surface measured on mo/day/yr
Pump test data: Well water was ft. after hours pumping gpm
Est. Yield: 6 gpm Well water was ft. after hours pumping gpm
Bore Hole Diameter: 9 in. to 260' ft., and in. to ft.
WELL WATER TO BE USED AS:
 1 Domestic 3 Feedlot 6 Oil field water supply 9 Dewatering 12 Other (Specify below)
 2 Irrigation 4 Industrial 7 Lawn and garden only 10 Monitoring well
Was a chemical/bacteriological sample submitted to Department? Yes.....No.....; If yes, mo/day/yr sample was submitted
Water Well Disinfected? Yes No

5 TYPE OF BLANK CASING USED:
1 Steel 3 RMP (SR) 5 Wrought iron 8 Concrete tile CASING JOINTS: Glued Clamped
 2 PVC 4 ABS 6 Asbestos-Cement 9 Other (specify below) Welded
Blank casing diameter: 5 in. to 240 ft., Dia. in. to ft., Dia. in. to ft.
Casing height above land surface: 2' in., weight 56.40 lbs./ft. Wall thickness or gauge No.
TYPE OF SCREEN OR PERFORATION MATERIAL:
1 Steel 3 Stainless steel 5 Fiberglass 8 RMP (SR) 10 Asbestos-cement
2 Brass 4 Galvanized steel 6 Concrete tile 9 ABS 12 None used (open hole)
SCREEN OR PERFORATION OPENINGS ARE:
1 Continuous slot 3 Mill slot 5 Gauzed wrapped 8 Saw cut 11 None (open hole)
2 Louvered shutter 4 Key punched 6 Wire wrapped 9 Drilled holes
3 Screen-perforated intervals: From 240 ft. to 260 ft., From ft. to ft.
GRAVEL PACK INTERVALS: From 25 ft. to 260 ft., From ft. to ft.

6 GROUT MATERIAL: 1 Neat cement 2 Cement grout 3 Bentonite 4 Other
Grout intervals: From 0 ft. to 25 ft., From ft. to ft.
What is the nearest source of possible contamination:
1 Septic tank 4 Lateral lines 7 Pit privy 10 Livestock pens 14 Abandoned water well
2 Sewer lines 5 Cess pool 8 Sewage lagoon 11 Fuel storage 15 Oil well/Gas well
3 Watertight sewer lines 6 Seepage pit 9 Feedyard 12 Fertilizer storage 16 Other (specify below)
13 Insecticide storage
Direction from well? West How many feet? 100'

FROM	TO	LITHOLOGIC LOG	FROM	TO	PLUGGING INTERVALS
0	1	Top Soil	133	151	Brown Shale
1	3	Limestone	151	159	Limestone
3	7	Brown Shale	159	170	Grey Shale
7	9	Limestone	170	186	Limestone
9	19	yellow shale	186	194	Brown Shale (water)
19	21	Limestone	194	219	Limestone
21	30	yellow shale	219	228	Brown shale
30	31	Limestone	228	237	Limestone
31	56	Brown shale	237	244	Grey Shale
56	88	Grey shale	244	256	Limestone
88	94	Limestone	256	260	Grey Shale
94	98	Greenish shale			
98	104	Limestone			
104	124	Grey Shale			
124	133	Limestone			

7 CONTRACTOR'S OR LANDOWNER'S CERTIFICATION: This water well was (1) constructed, (2) reconstructed, or (3) plugged under my jurisdiction and was completed on (mo/day/year) 6/29/92 and this record is true to the best of my knowledge and belief. Kansas Water Well Contractor's License No. 451 This Water Well Record was completed on (mo/day/yr) 7/19/92 under the business name of Haldeman Well Drilling by (signature) Craig Haldeman

INSTRUCTIONS: Use typewriter or ball point pen. PLEASE PRESS FIRMLY and PRINT clearly. Please fill in blanks, underline or circle the correct answers. Send two copies to Kansas Department of Health and Environment, Bureau of Water, Topeka, Kansas 66620-0001. Telephone: 913-296-5545. Send one to WATER WELL OWNER and retain one for your records.