


1 LOCATION OF WATER WELL: County: Riley Fraction: SE 1/4 SE 1/4 SE 1/4 Section Number: 13 Township Number: T 8 S Range Number: R 6 E/W

Distance and direction from nearest town or city street address of well if located within city? From Manhattan GO North on 24 + 77 17 Miles + GO West 2 3/4 Miles

2 WATER WELL OWNER: Bill SABO  
 RR#, St. Address, Box #: RR #1 BOX #167  
 City, State, ZIP Code: YUTON, MO 68073  
 Board of Agriculture, Division of Water Resources  
 Application Number:

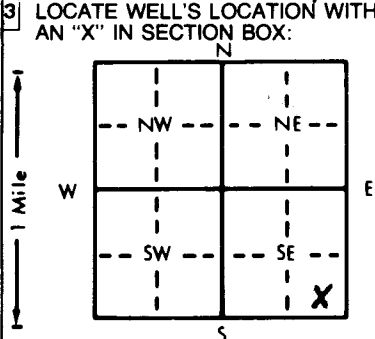

4 DEPTH OF COMPLETED WELL: 180 ft. ELEVATION: ..... ft.  
 Depth(s) Groundwater Encountered 1. 137 ft. 2. .... ft. 3. .... ft.  
 WELL'S STATIC WATER LEVEL: 130 ft. below land surface measured on mo/day/yr .....  
 Pump test data: Well water was ..... ft. after ..... hours pumping ..... gpm  
 Est. Yield: 6 gpm Well water was ..... ft. after ..... hours pumping ..... gpm  
 Bore Hole Diameter: 9 in. to 180 ft., and ..... in. to ..... ft.  
 WELL WATER TO BE USED AS:  
 1 Domestic (circled) 3 Feedlot 6 Oil field water supply 9 Dewatering 12 Other (Specify below)  
 2 Irrigation 4 Industrial 7 Lawn and garden only 10 Monitoring well  
 Was a chemical/bacteriological sample submitted to Department? Yes.....No.....; If yes, mo/day/yr sample was submitted  
 Water Well Disinfected? Yes No

5 TYPE OF BLANK CASING USED:  
 1 Steel (circled) 3 RMP (SR) 5 Wrought iron 8 Concrete tile CASING JOINTS: Glued Clamped  
 2 PVC (circled) 4 ABS 6 Asbestos-Cement 9 Other (specify below) Welded  
 7 Fiberglass Threaded  
 Blank casing diameter: 5 in. to 160 ft., Dia. .... in. to .... ft., Dia. .... in. to .... ft.  
 Casing height above land surface: 2' in., weight: Sch 40 lbs./ft. Wall thickness or gauge No. ....  
 TYPE OF SCREEN OR PERFORATION MATERIAL:  
 1 Steel 3 Stainless steel 5 Fiberglass 8 RMP (SR) 10 Asbestos-cement  
 2 Brass 4 Galvanized steel 6 Concrete tile 9 ABS 11 Other (specify) 12 None used (open hole)  
 SCREEN OR PERFORATION OPENINGS ARE:  
 1 Continuous slot 3 Mill slot (circled) 25/3000 5 Gauzed wrapped 8 Saw cut 11 None (open hole)  
 2 Louvered shutter 4 Key punched 6 Wire wrapped 9 Drilled holes 10 Other (specify)  
 SCREEN-PERFORATED INTERVALS: From 160 ft. to 180 ft., From ..... ft. to ..... ft.  
 From ..... ft. to ..... ft., From ..... ft. to ..... ft.  
 GRAVEL PACK INTERVALS: From 25 ft. to 180 ft., From ..... ft. to ..... ft.  
 From ..... ft. to ..... ft., From ..... ft. to ..... ft.

6 GROUT MATERIAL: 1 Neat cement 2 Cement grout 3 Bentonite (circled) 4 Other  
 Grout Intervals: From 0 ft. to 25 ft., From ..... ft. to ..... ft., From ..... ft. to ..... ft.  
 What is the nearest source of possible contamination: None Close  
 1 Septic tank 4 Lateral lines 7 Pit privy 10 Livestock pens 14 Abandoned water well  
 2 Sewer lines 5 Cess pool 8 Sewage lagoon 11 Fuel storage 15 Oil well/Gas well  
 3 Watertight sewer lines 6 Seepage pit 9 Feedyard 12 Fertilizer storage 16 Other (specify below)  
 13 Insecticide storage  
 Direction from well? How many feet?

FROM	TO	LITHOLOGIC LOG	FROM	TO	PLUGGING INTERVALS
0	1	Top Soil	82	91	Limestone
1	2	Limestone	91	102	Grey Shale
2	5	Yellow Shale	102	112	Brown Shale
5	7	Limestone	112	116	Limestone
7	10	Yellow Shale	116	131	Brown Shale
10	13	Limestone	131	134	Grey Shale
13	21	Yellow Shale	134	142	Limestone (Water)
21	33	Brown Shale	142	152	Brown Shale
33	37	Limestone	152	155	Limestone
37	49	Grey Shale	155	156	Brown Shale
49	54	Limestone	156	161	Limestone
54	61	Yellow Shale	161	166	Grey Shale
61	70	Grey Shale	166	171	Limestone
70	76	Limestone	171	180	Grey Shale
76	82	Grey Shale			

7 CONTRACTOR'S OR LANDOWNER'S CERTIFICATION: This water well was (1) constructed (2) reconstructed, or (3) plugged under my jurisdiction and was completed on (mo/day/year) 8/10/92 and this record is true to the best of my knowledge and belief. Kansas Water Well Contractor's License No. 451 This Water Well Record was completed on (mo/day/yr) 8/16/92 under the business name of Haldeman Well by (signature) Craig H. EWYPA

OFFICE USE ONLY  
T  
R  
EW  
SEC.