


Golden Shores add. north west corner lot no 18

1 LOCATION OF WATER WELL: County: Riley Section Number 13 Township Number T 8 S Range Number R 6 E

Distance and direction from nearest town or city street address of well if located within city? Randolph southern 7 1/2 miles east 2 1/2 mi 3/4 mile north

2 WATER WELL OWNER: ART RECK (check) 66502  
 RR#, St. Address, Box # RR 4 Western shores Board of Agriculture, Division of Water Resources  
 City, State, ZIP Code Manhattan KS Application Number:

3 LOCATE WELL'S LOCATION WITH AN "X" IN SECTION BOX:

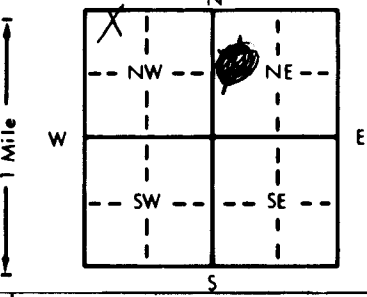

4 DEPTH OF COMPLETED WELL: 178 ft. ELEVATION:  
 Depth(s) Groundwater Encountered 1. 53 ft. 2. ft. 3. ft.  
 WELL'S STATIC WATER LEVEL 53 ft. below land surface measured on mo/day/yr June 13-83  
 Pump test data: Well water was ft. after hours pumping gpm  
 Est. Yield 1 1/2 gpm: Well water was ft. after hours pumping gpm  
 Bore Hole Diameter 10 in. to 14 in. and 6 1/2 in. to 178 in.  
 WELL WATER TO BE USED AS:  
 1 Domestic  3 Feedlot  6 Oil field water supply  9 Dewatering  12 Other (Specify below)  
 2 Irrigation  4 Industrial  7 Lawn and garden only  10 Observation well  
 Was a chemical/bacteriological sample submitted to Department? Yes.....No........ If yes, mo/day/yr sample was submitted  
 Water Well Disinfected? Yes  No

5 TYPE OF CASING USED:  
 1 Steel  3 RMP (SR)  5 Wrought iron  8 Concrete tile CASING JOINTS: Glued  Clamped.....  
 2 PVC  4 ABS  6 Asbestos-Cement  9 Other (specify below) Welded.....  
 7 Fiberglass Threaded.....  
 Blank casing diameter 5 in. to 50 in. Dia. 5 in. to 90 in. Dia. 5 in. to 90 to 178 in. Dia.  
 Casing height above land surface 12 in., weight 200 P.S.F. lbs./ft. Wall thickness or gauge No. 2 65

TYPE OF SCREEN OR PERFORATION MATERIAL:  
 1 Steel  3 Stainless steel  5 Fiberglass  8 RMP (SR)  11 Other (specify).....  
 2 Brass  4 Galvanized steel  6 Concrete tile  9 ABS  12 None used (open hole)

SCREEN OR PERFORATION OPENINGS ARE:  
 1 Continuous slot  3 Mill slot  5 Gauzed wrapped  8 Saw cut  11 None (open hole)  
 2 Louvered shutter  4 Key punched  6 Wire wrapped  9 Drilled holes  
 7 Torch cut  10 Other (specify).....

SCREEN-PERFORATED INTERVALS: From 30 ft. to 90 ft., From ft. to ft.  
 GRAVEL PACK INTERVALS: From none ft. to ft., From ft. to ft.

6 GROUT MATERIAL:  1 Neat cement  2 Cement grout  3 Bentonite  4 Other.....  
 Grout Intervals: From 14 ft. to 4 ft., From ft. to ft., From ft. to ft.

What is the nearest source of possible contamination:  
 1 Septic tank  4 Lateral lines  7 Pit privy  10 Livestock pens  14 Abandoned water well  
 2 Sewer lines  5 Cess pool  8 Sewage lagoon  11 Fuel storage  15 Oil well/Gas well  
 3 Watertight sewer lines  6 Seepage pit  9 Feedyard  12 Fertilizer storage  16 Other (specify below) ditch or Draw  
 13 Insecticide storage  14 Other (specify below)

Direction from well? North How many feet? 200

FROM	TO	LITHOLOGIC LOG	FROM	TO	LITHOLOGIC LOG
0	4	top soil			
4	20	Rock, Limestone			
20	42	Shale, Blue			
42	54	Rock, Limestone			
54	69	Shale, Blue			
69	79	Shale, Red			
79	117	Rock Very hard blue			
117	140	" " " "			
140	169	Blue, Shale			
169	178	Shale, Red			

7 CONTRACTOR'S OR LANDOWNER'S CERTIFICATION: This water well was (1) constructed, (2) reconstructed, or (3) plugged under my jurisdiction and was completed on (mo/day/year) June 13 - 83 and this record is true to the best of my knowledge and belief. Kansas Water Well Contractor's License No. 237 This Water Well Record was completed on (mo/day/yr) June 14 - 83 under the business name of Strader Drilling Co by (signature) Harold Strader

INSTRUCTIONS: Use typewriter or ball point pen, PLEASE PRESS FIRMLY and PRINT clearly. Please fill in blanks, underline or circle the correct answers. Send top three copies to Kansas Department of Health and Environment, Division of Environment, Environmental Geology Section, Topeka, KS 66620. Send one to WATER WELL OWNER and retain one for your records.

OFFICE USE ONLY  
T  
R  
6  
SEC. 13  
11/14  
11/14  
11/14