

USE TYPEWRITER OR BALL POINT PEN-PRESS FIRMLY, PRINT CLEARLY.


WATER WELL RECORD  
KSD 1201-1215

Kansas Department of Health and Environment-Division of Environment  
(Water well Contractors)  
Topeka, Kansas 66620

SE 1/4 of NE 1/4 of

1. Location of well: County Riley Fraction NE 1/4 Section number 31 Township number 8 South Range number 6 east

2. Distance and direction from nearest town or city: 2 north of Riley 3. Owner of well: Dean K. Larty  
Street address of well location if in city: 2 east and 1/4 south R.R. or street: R.R. # City, state, zip code: Riley, Kans

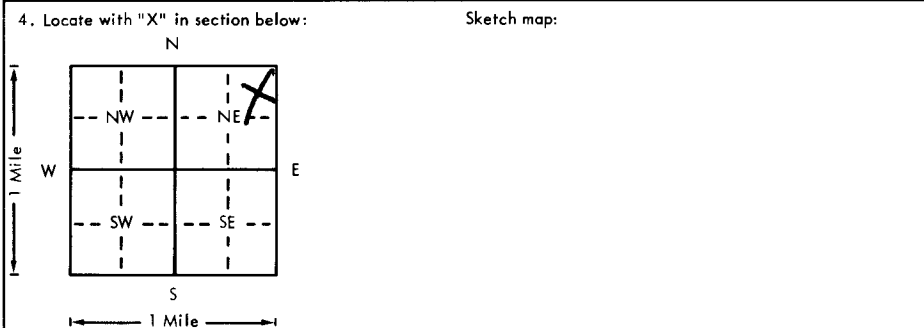

6. Bore hole dia. 1 1/2 in. Completion date 8-18-77  
Well depth 98 ft.

7.  Cable tool  Rotary  Driven  Dug  
 Hollow rod  Jetted  Bored  Reverse rotary

8. Use:  Domestic  Public supply  Industry  
 Irrigation  Air conditioning  Stock  
 Lawn  Oil field water  Other

9. Casing: Material PVC Height: Above or below  
Threaded  Welded  Surface 14 in.  
RMP  PVC  Weight          lbs./ft.  
Dia. 5 in. to 98 ft. depth Wall Thickness: inches  
Dia.          in. to          ft. depth gage No. 200 P.S. 1

5. Type and color of material	From	To
Top soil	0	3
Shale Red	3	34
Rocks Hard Limestone	34	45
Shale Brown	45	51
Rocks Limestone	51	70
Rocks Limestone	70	80
Rocks Soft Limestone	80	81
Shale Blue hard	81	98

10. Screen: Manufacturer's name Pumpco 267 Wall  
Type P.V.C. M.P.I. Dia. 5  
Slot/gauze 1.50 Length 40  
Set between 42 ft. and 82 ft.  
         ft. and          ft.  
Gravel pack?  Size range of material 1/4" X 1/2"

11. Static water level: 46 ft. below land surface Date 8-18-77  
No./day/yr.         

12. Pumping level below land surfaces:  
         ft. after          hrs. pumping          g.p.m.  
         ft. after          hrs. pumping          g.p.m.  
Estimated maximum yield over 30 g.p.m.

13. Water sample submitted:          mo./day/yr.  
Yes  No  Date         

14. Well head completion: NA  
 Pitless adapter          inches above grade

15. Well grouted?   
With:  Neat cement  Bentonite  Concrete  
Depth: From 18 ft. to 0 ft.

16. Nearest source of possible contamination: Septic tank  
ft. 500 Direction S.E. Type Septic tank  
Well disinfected upon completion?  Yes  No

17. Pump:  Not installed  
Manufacturer's name           
Model number          HP          Volts           
Length of drop pipe          ft. capacity          g.p.m.  
Type:  
 Submersible  Turbine  
 Jet  Reciprocating  
 Centrifugal  Other

18. Elevation:          19. Remarks:         

20. Water well contractor's certification:  
This well was drilled under my jurisdiction and this report is true to the best of my knowledge and belief.  
Strader Drilling Co 2377 SE 1/4 1/4  
Business name Blue Rapids License No.           
Address           
Signed Harold Strader Date 8-18-77  
Authorized representative

Forward the white, blue and pink copies to the Department of Health and Environment

Form WWC-5