


1 LOCATION OF WATER WELL: County: Riley Fraction NE ~~SE~~ 1/4 SE 1/4 NE 1/4 Section Number 18 Township Number T 8 S Range Number R 6 EW

Distance and direction from nearest town or city street address of well if located within city?  
3 mile's East of Leonardville

2 WATER WELL OWNER: Aaron Ohlde  
 RR#, St. Address, Box #: 10581 Walnut Creek R.D.  
 City, State, ZIP Code: Leonardville KS. 66449  
 Board of Agriculture, Division of Water Resources  
 Application Number:

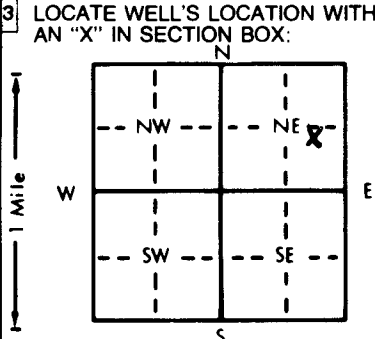

4 DEPTH OF COMPLETED WELL: 65 ft. ELEVATION:  
 Depth(s) Groundwater Encountered 1. 10 ft. 2. ft. 3. ft.  
 WELL'S STATIC WATER LEVEL 10 ft. below land surface measured on mo/day/yr  
 Pump test data: Well water was ft. after hours pumping gpm  
 Est. Yield gpm: Well water was ft. after hours pumping gpm  
 Bore Hole Diameter in. to ft., and in. to ft.  
 WELL WATER TO BE USED AS:  
 1 Domestic  2 Irrigation  3 Feedlot  4 Industrial  5 Public water supply  6 Oil field water supply  7 Lawn and garden only  8 Air conditioning  9 Dewatering  10 Monitoring well  11 Injection well  12 Other (Specify below)  
 Was a chemical/bacteriological sample submitted to Department? Yes.....No.....; If yes, mo/day/yr sample was submitted  
 Water Well Disinfected? Yes No

5 TYPE OF BLANK CASING USED:  
 1 Steel  2 PVC  3 RMP (SR)  4 ABS  5 Wrought iron  6 Asbestos-Cement  7 Fiberglass  8 Concrete tile  9 Other (specify below)  10 Monitoring well  
 Blank casing diameter 4 in. to ft., Dia. in. to ft., Dia. in. to ft.  
 Casing height above land surface 3 Foot + Below weight lbs./ft. Wall thickness or gauge No.  
 TYPE OF SCREEN OR PERFORATION MATERIAL:  
 1 Steel  2 Brass  3 Stainless steel  4 Galvanized steel  5 Fiberglass  6 Concrete tile  7 PVC  8 RMP (SR)  9 ABS  10 Asbestos-cement  11 Other (specify) NA  12 None used (open hole)  
 SCREEN OR PERFORATION OPENINGS ARE:  
 1 Continuous slot  2 Louvered shutter  3 Mill slot  4 Key punched  5 Gauzed wrapped  6 Wire wrapped  7 Torch cut  8 Saw cut  9 Drilled holes  10 Other (specify) NA  11 None (open hole)  
 SCREEN-PERFORATED INTERVALS: From NA ft. to NA ft., From ft. to ft., From ft. to ft., From ft. to ft.  
 GRAVEL PACK INTERVALS: From ft. to ft., From ft. to ft., From ft. to ft., From ft. to ft.

6 GROUT MATERIAL:  1 Neat cement  2 Cement grout  3 Bentonite  4 Other  
 Grout Intervals: From 54 ft. to 6 ft., From ft. to ft., From ft. to ft., From ft. to ft.  
 What is the nearest source of possible contamination:  
 1 Septic tank  2 Sewer lines  3 Watertight sewer lines  4 Lateral lines  5 Cess pool  6 Seepage pit  7 Pit privy  8 Sewage lagoon  9 Feedyard  10 Livestock pens  11 Fuel storage  12 Fertilizer storage  13 Insecticide storage  14 Abandoned water well  15 Oil well/Gas well  16 Other (specify below)  
 Direction from well? West How many feet? 55 Foot

FROM	TO	LITHOLOGIC LOG	FROM	TO	PLUGGING INTERVALS
<u>65</u>	<u>54</u>	<u>Sand</u>			
<u>63</u>	<u>57</u>	<u>Sand</u>			
<u>54</u>	<u>6</u>	<u>Bentonite</u>			
<u>6</u>	<u>3</u>	<u>Cement grout</u>			

7 CONTRACTOR'S OR LANDOWNER'S CERTIFICATION: This water well was (1) constructed, (2) reconstructed, or  (3) plugged under my jurisdiction and was completed on (mo/day/year) 9-28-94 and this record is true to the best of my knowledge and belief. Kansas Water Well Contractor's License No. This Water Well Record was completed on (mo/day/yr) 9-28-94 under the business name of by (signature) Aaron L Ohlde

OFFICE USE ONLY  
T  
R  
EW  
SEC.  
1/4  
1/4  
1/4