

CORRECTION TO WATER WELL RECORD (WWC-5)

The following correction(s) was made to the attached WWC-5 log, in order to file the item or to rectify lacking or incorrect information.

Fraction ( 1/4 1/4 1/4) Section-Township-Range changed:

listed as SW SW NW, 20-28S-8W

changed to SW SW NW, 20-8S-7E

Other changes: Initial statements: \_\_\_\_\_

Changed to: \_\_\_\_\_

Comments: \_\_\_\_\_


verification method: Written & legal descriptions, well owner's address, position on plat map, area map on internet, and initials: NRK date: 5/23/2001  
Olsburg SW 1:24,000 topo. map.

submitted by: Kansas Geological Survey, Data Resources Library, 1930 Constant Ave., Lawrence, KS 66047-3726  
to: Kansas Dept of Health & Environment Bureau of Water Industrial Programs, Bldg 283, Forbes Field, KS 66620

1 LOCATION OF WATER WELL: Fraction SW 1/4 SW 1/4 NW 1/4 Section Number 20 Township Number T 28 S Range Number R 8 EW  
 County: RILEY

Distance and direction from nearest town or city street address of well if located within city?  
10 M-N + 5 M-E IF MANHATTAN-LAKE VIEW - BLUE RIDGE HILLS. -

2 WATER WELL OWNER: JON T. FUNK  
 RR#, St. Address, Box #: 9617 LAKE SHORE DR RILEY KS 66531  
 City, State, ZIP Code: RILEY KS 66531  
 Board of Agriculture, Division of Water Resources  
 Application Number: -

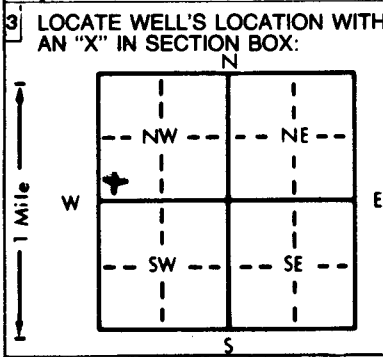

4 DEPTH OF COMPLETED WELL: 96 ft. ELEVATION: -  
 Depth(s) Groundwater Encountered 1. 69.6 ft. 2. - ft. 3. - ft.  
 WELL'S STATIC WATER LEVEL 69 ft. below land surface measured on mo/day/yr 03-30-93  
 \* Pump test data: Well water was - ft. after - hours pumping - gpm  
 Est. Yield 5 gpm: Well water was - ft. after - hours pumping - gpm  
 Bore Hole Diameter 10 in. to 20 ft., and 7 in. to 100 ft.  
 WELL WATER TO BE USED AS:  
 5 Public water supply 8 Air conditioning 11 Injection well  
 1 Domestic 3 Feedlot 6 Oil field water supply 9 Dewatering 12 Other (Specify below)  
 2 Irrigation 4 Industrial 7 Lawn and garden only 10 Monitoring well -  
 Was a chemical/bacteriological sample submitted to Department? Yes - No X; If yes, mo/day/yr sample was submitted -  
 Water Well Disinfected? Yes X No -

5 TYPE OF BLANK CASING USED:  
 1. Steel 3 RMP (SR) 6 Asbestos-Cement 9 Other (specify below) Welded -  
 2 PVC 4 ABS 7 Fiberglass Threaded -  
 Blank casing diameter 5 in. to 56 ft., Dia - in. to - ft., Dia - in. to - ft.  
 Casing height above land surface 24 in., weight SCH 40 lbs./ft. Wall thickness or gauge No. -

TYPE OF SCREEN OR PERFORATION MATERIAL:  
 1 Steel 3 Stainless steel 5 Fiberglass 8 RMP (SR) 10 Asbestos-cement  
 2 Brass 4 Galvanized steel 6 Concrete tile 9 ABS 11 Other (specify) -  
 12 None used (open hole)  
 SCREEN OR PERFORATION OPENINGS ARE:  
 5 Gauzed wrapped 8 Saw cut 11 None (open hole)  
 1 Continuous slot 3 Mill slot 6 Wire wrapped 9 Drilled holes  
 2 Louvered shutter 4 Key punched 7 Torch cut 10 Other (specify) -

SCREEN-PERFORATED INTERVALS: From 56 ft. to 96 ft., From - ft. to - ft., From - ft. to - ft.  
 From - ft. to - ft., From - ft. to - ft., From - ft. to - ft.  
~~GRAVEL~~ SAND PACK INTERVALS: From 52 ft. to 96 ft., From - ft. to - ft., From - ft. to - ft.  
 From - ft. to - ft., From - ft. to - ft., From - ft. to - ft.

6 GROUT MATERIAL: 1 Neat cement 2 Cement grout 3 Bentonite 4 Other BENTONITE / CEMENT BRDT  
 Grout Intervals: From 4 ft. to 47 ft., From 43 ft. to 47 ft., From 52 ft. to - ft., From - ft. to - ft.  
 What is the nearest source of possible contamination: NA  
 1 Septic tank 4 Lateral lines 7 Pit privy 10 Livestock pens 14 Abandoned water well  
 2 Sewer lines 5 Cess pool 8 Sewage lagoon 11 Fuel storage 15 Oil well/Gas well  
 3 Watertight sewer lines 6 Seepage pit 9 Feedyard 12 Fertilizer storage 16 Other (specify below)  
 13 Insecticide storage  
 Direction from well? - How many feet? -

FROM	TO	LITHOLOGIC LOG	FROM	TO	PLUGGING INTERVALS
0	5	FILL	54	59	SHALE
5	7.5	CHERT / LIME	59	61	CHERTY LIME
7.5	13	SHALE	61	68	SHALE
13	15.5	CHERT / LIME	68	70	LIME / CHERT
15.5	22	SHALE	70	80.5	SHALE
22	24	SKALE RED	80.5	83.5	LIME
24	27	LIME / CHERT	83.5	87.5	LAYERS - CHERT + LIME
27	35	SHALE	87.5	89	LIME - CHERTY
35	37	SHALE RED	89	97	SHALE
37	40	LIME / CHERT	97	100	LIME - CHERTY
40	44	SHALE	* WELL WAS PUMPED DOWN TO 87.5' HELD 87.5 AT PUMP RATE OF 5 GAL PER 69 SEC. RECHARGE RATE 1'-34S		
44	47	SHALE RED			
47	53	LIME CHERTY			
53	53.5	LIME			
53.5	54	CHERT			

7 CONTRACTOR'S OR LANDOWNER'S CERTIFICATION: This water well was (1) constructed, (2) reconstructed, or (3) plugged under my jurisdiction and was completed on (mo/day/year) 03-30-93 and this record is true to the best of my knowledge and belief. Kansas Water Well Contractor's License No. 479 This Water Well Record was completed on (mo/day/yr) 04-16-93 under the business name of EBBERTS DRILLING by (signature) 04-16-93 [Signature]