


1 LOCATION OF WATER WELL: Fraction Section Number Township Number Range Number
 County: POTTAWATOMIE SE 1/4 SE 1/4 SE 1/4 15 T 8 S R 7 EW

Distance and direction from nearest town or city street address of well if located within city?
 1/2 west, 5 1/2 south of Oldsburg

2 WATER WELL OWNER: Bob Barr
 RR#, St. Address, Box #: 206 Noble St. Board of Agriculture, Division of Water Resources
 City, State, ZIP Code: Riley, KS 66531 Application Number:

3 LOCATE WELL'S LOCATION WITH AN "X" IN SECTION BOX:

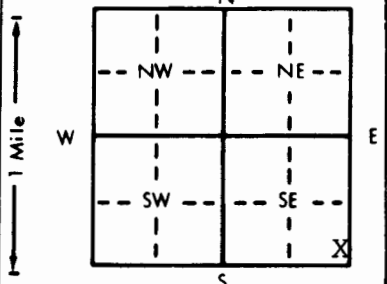

4 DEPTH OF COMPLETED WELL: 140' ft. ELEVATION:

Depth(s) Groundwater Encountered 1. 30' ft. 2. ft. 3. ft.
 WELL'S STATIC WATER LEVEL 28' ft. below land surface measured on mo/day/yr 1-3-90
 Pump test data: Well water was ft. after hours pumping gpm
 Est. Yield 4 gpm: Well water was ft. after hours pumping gpm
 Bore Hole Diameter 8 3/4 in. to ft., and in. to ft.
 WELL WATER TO BE USED AS:
 5 Public water supply 8 Air conditioning 11 Injection well
 1 Domestic 3 Feedlot 6 Oil field water supply 9 Dewatering 12 Other (Specify below)
 2 Irrigation 4 Industrial 7 Lawn and garden only 10 Monitoring well
 Was a chemical/bacteriological sample submitted to Department? Yes No X; If yes, mo/day/yr sample was submitted
 Water Well Disinfected? Yes X No

5 TYPE OF BLANK CASING USED: 5 Wrought iron 8 Concrete tile CASING JOINTS: Glued X Clamped

1 Steel 3 RMP (SR) 6 Asbestos-Cement 9 Other (specify below) Welded
 2 PVC 4 ABS 7 Fiberglass Threaded
 Blank casing diameter 5" in. to 0-22 ft., Dia 5" in. to 42-100 ft., Dia 5" in. to 120-140 ft.
 Casing height above land surface 24" in., weight 2.82 lbs./ft. Wall thickness or gauge No. 258

TYPE OF SCREEN OR PERFORATION MATERIAL:
 1 Steel 3 Stainless steel 5 Fiberglass 8 RMP (SR) 11 Other (specify)
 2 Brass 4 Galvanized steel 6 Concrete tile 9 ABS 12 None used (open hole)

SCREEN OR PERFORATION OPENINGS ARE:
 1 Continuous slot 3 Mill slot 5 Gauzed wrapped 8 Saw cut 11 None (open hole)
 2 Louvered shutter 4 Key punched 6 Wire wrapped 9 Drilled holes
 7 Torch cut 10 Other (specify)

SCREEN-PERFORATED INTERVALS: From 22 ft. to 42 ft., From ft. to ft.
 From 100 ft. to 120 ft., From ft. to ft.
 GRAVEL PACK INTERVALS: From 22 ft. to 140' ft., From ft. to ft.
 From ft. to ft., From ft. to ft.

6 GROUT MATERIAL: 1 Neat cement 2 Cement grout 3 Bentonite 4 Other hole plug

Grout Intervals: From 0 ft. to 22 ft., From ft. to ft., From ft. to ft.
 What is the nearest source of possible contamination:
 1 Septic tank 4 Lateral lines 7 Pit privy 10 Livestock pens 14 Abandoned water well
 2 Sewer lines 5 Cess pool 8 Sewage lagoon 11 Fuel storage 15 Oil well/Gas well
 3 Watertight sewer lines 6 Seepage pit 9 Feedyard 12 Fertilizer storage 16 Other (specify below)
 13 Insecticide storage
 Direction from well? East How many feet 225'

FROM	TO	LITHOLOGIC LOG	FROM	TO	PLUGGING INTERVALS
0	13	Clay-Brown			
13	17	Limestone-Yellow			
17	22	Shale-Yellow			
22	33	Shale-Grey			
33	35	Shale-Red			
35	44	Shale-Tan			
44	52	Limestone-Tan			
52	58	Shale-Tan			
58	59	Limestone-Tan			
59	64	Shale-Tan			
64	70	Shale-Red			
70	96	Shaley Limestone-Grey			
96	105	Limestone-Grey			
105	140	Shaley Limestone-Grey			

7 CONTRACTOR'S OR LANDOWNER'S CERTIFICATION: This water well was (1) constructed, (2) reconstructed, or (3) plugged under my jurisdiction and was completed on (mo/day/year) 1-03-90 and this record is true to the best of my knowledge and belief. Kansas Water Well Contractor's License No. 182 This Water Well Record was completed on (mo/day/yr) 2-9-90 under the business name of STRADER DRILLING CO., INC. by (signature) Dale W. Strader

INSTRUCTIONS: Use typewriter or ball point pen. PLEASE PRESS FIRMLY and PRINT clearly. Please fill in blanks, underline or circle the correct answers. Send top three copies to Kansas Department of Health and Environment, Bureau of Water Protection, Topeka, Kansas 66620-7320. Telephone: 913-296-5514. Send one to WATER WELL OWNER and retain one for your records.